


Section 6 Township 11 Range 16W

Well No. #1 Neuer

Company ChamplinRef.

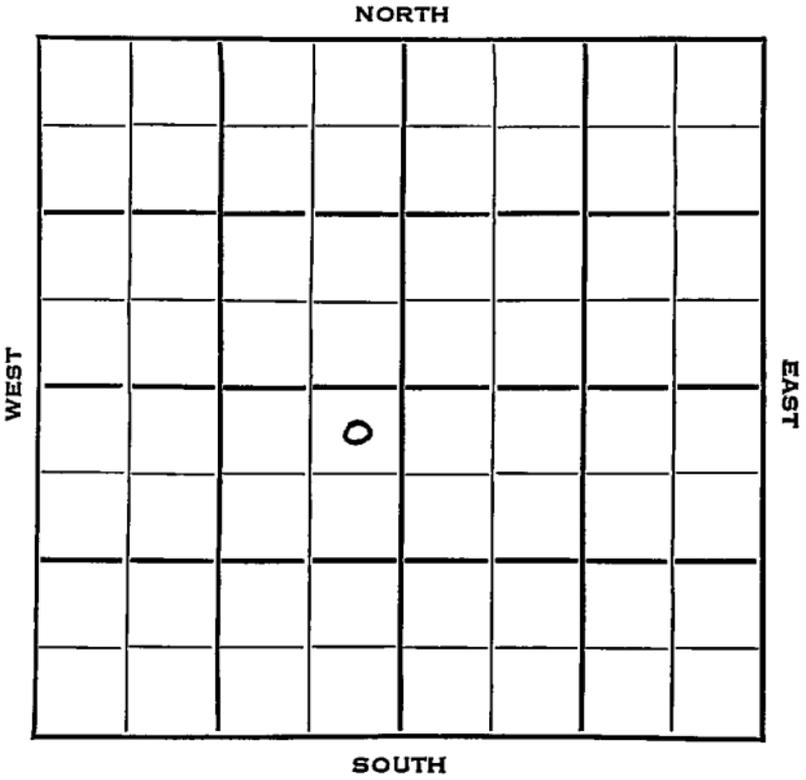



Sec. 6 Twp. 11 R. 16 W

Well No. # 1 Neuer Farm

Champlin Ref. Company

Contractor


330 Ft. from N. Line

Ft. from S. Line

330 Ft. from E. Line

Ft. from W. Line

NE NE SW

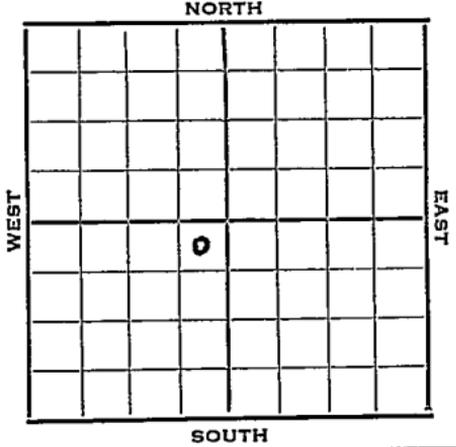

1953 Elev. 1904' REPORT

7/29 MIR

8/5 8" @ 130  
Top 2829, Heeb 3064, Tor 3084, Lans 3107  
Drlg. 3120'

8/12 Spud 7-27-53 D & A TD 3555  
8" @ 130 Top 2829 Heeb 3064  
Tor. 3084 Lans 3107 B KC 3348  
Cong 3391  
DST 3390-3405 open 1/2 hr rec 10' mud 450#  
DST 3405-20 open 1/2 hr rec 30' mud 150#  
Simp. 3482 Arb. 3523  
TD 3555' D & A

**ABANDONED**



