


Section 6 Township 11 Range 16W

Well No. #1 Neuer

Company H. J. Stormfeltz

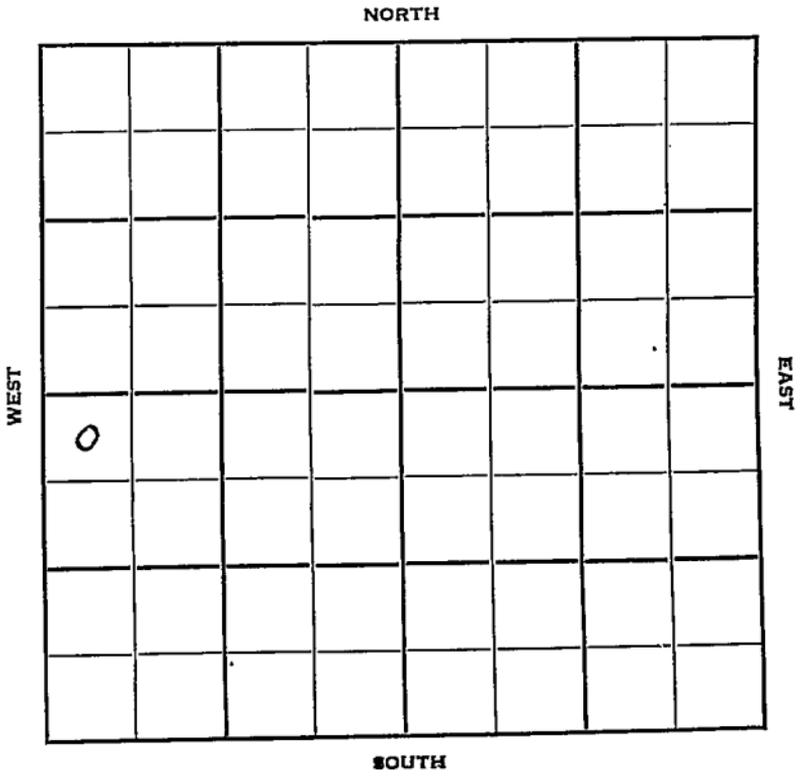

Sec. 6 Twp. 11 R. 16-W

Well No. #1 Neuer Farm

H J Stormfeltz Company


Contractor

330 Ft. from N. Line

Ft. from S. Line

Ft. from E. Line

330 Ft. from W. Line

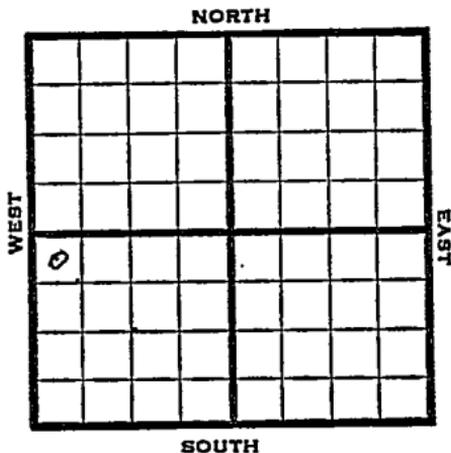

NW NW SW

1950

Elev 1842'

REPORT

4/12

TD 3475'
 8" @ 216'
 Topeka 2760'
 Heeb 2992'
 Dodge 3016'
 Lans 303 1/2'
 Arb. 3442-75

No shows.

D&A

Aband. & First Report

FIRST REPORT

+

ABANDONED

Kansas

Map No. _____ Sec. 6 Twp. 11 R. 16W

Well No. 1 Neuer

H. J. Stormfeltz Company

Contractor

NW NW SW

EI. 1842
SECTION PLAT

330 Ft. from N. Line

_____ Ft. from S. Line

_____ Ft. from E. Line

330 Ft. from W. Line

FIRST REPORT			
ABANDONED			
o			

Ellis County

Location _____

Rig up _____

Drilling and Remarks:

*8" @ 216
Tepuka 2760
Keb 2992
Dodge 3016
Lens 3034
Nov 3442-75*

RECORD

Cased _____ in., _____ ft.
Sand _____
Gas _____
Oil _____
Total Depth 3475

PRODUCTION

1st 24 hrs. Nat. _____
1st 24 hrs. after shot _____
Gas _____ Cu. Ft.
Dry Hole _____
Abandoned _____

no shows DTA

Date

APR 12 1950

J. E. TYRA Scout