

# KANSAS

Form 51-5M-7-40-Palace


Ellis

Section 6 Township 11 Range 17-W

Well No. #1 Henderson "C"

Company Dickey

NORTH Bemis Pool

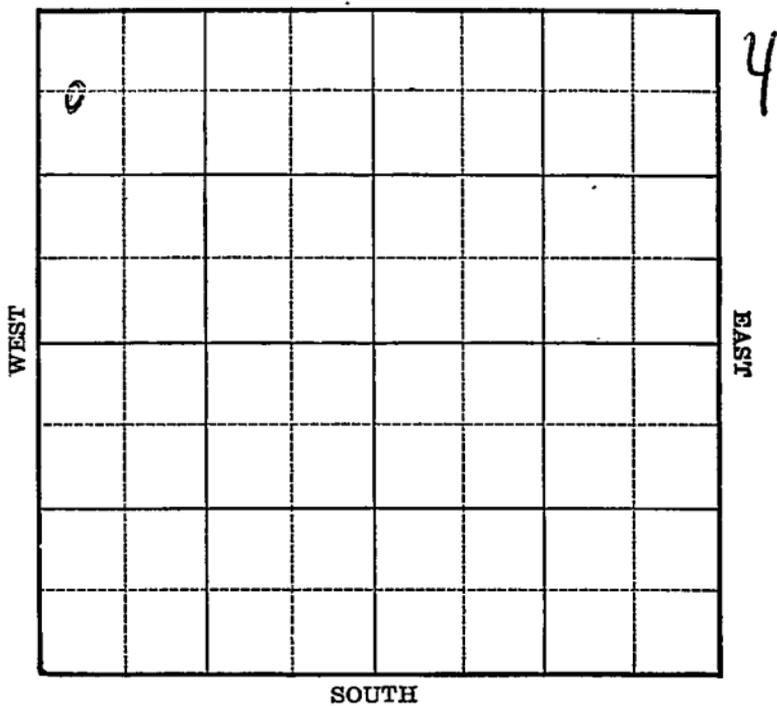

Sec. 6 Twp. 11 R. 17-W

Well No. #1 Henderson "C" Farm

Dickey Company

(Bemis)


660 Ft. from N. Line

Ft. from S. Line

Ft. from E. Line

330 Ft. from W. Line

Elev. 1984

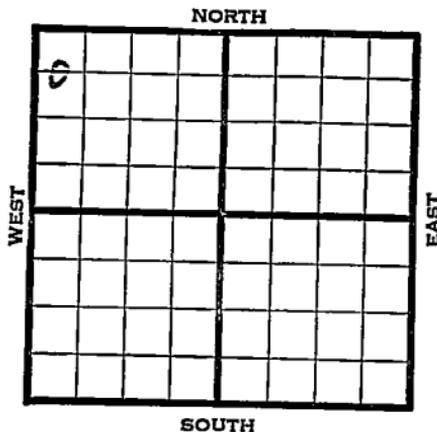

1940	REPORT
11/6	Derrick.
11/14	"
11/21	"
11/27	"
12/5	"
12/12	"
12/19	"
12/26	"
1941	
1/2	"
1/9	"
1/16	"
1/23	10" - 1271' Anhy. 12.57'
	Drig. 1900'
1/30	Drig. 3100'
2/5	Arb. 3554½'
	T.D. 3556'
	No shows.
	ABANDONED

Map No. 71 Sec. 6 Twp. 11 R. 17W

Well No. 1 Henderson "C"

Dickey Company

Contractor

### FIRST REPORT

C W L NW NW

### SECTION PLAT

660 Ft. from N. Line

0			

\_\_\_\_\_ Ft. from S. Line

\_\_\_\_\_ Ft. from E. Line

330 Ft. from W. Line

BEMIS POOL

Location \_\_\_\_\_

### RECORD

Rig up \_\_\_\_\_

Cased \_\_\_\_\_ in., \_\_\_\_\_ ft.

Drilling and Remarks:

Sand \_\_\_\_\_

Derrick

Gas \_\_\_\_\_

Oil \_\_\_\_\_

Total Depth \_\_\_\_\_

### PRODUCTION

1st 24 hrs. Nat. \_\_\_\_\_

1st 24 hrs. after shot \_\_\_\_\_

Gas \_\_\_\_\_ Cu. Ft.

Dry Hole \_\_\_\_\_

Abandoned \_\_\_\_\_

Date

NOV 6 1940 19

S. J. LEWIS Scout

Map No. 71 Sec. 6 Twp. 11 R. 17WWell No. 1 Henderson "C"Dickey Oil CompanyABANDONED Contractor

C W L NW NW

660 Ft. from N. Line       Ft. from S. Line       Ft. from E. Line330 Ft. from W. Line

BEMIS POOL

## SECTION PLAT

0			

Location \_\_\_\_\_

Rig up \_\_\_\_\_

Drilling and Remarks:

*Cor. 3554 1/2**No show*

## RECORD

Cased \_\_\_\_\_ in., \_\_\_\_\_ ft.

Sand \_\_\_\_\_

Gas \_\_\_\_\_

Oil \_\_\_\_\_

Total Depth 3556

## PRODUCTION

1st 24 hrs. Nat. \_\_\_\_\_

1st 24 hrs. after shot \_\_\_\_\_

Gas \_\_\_\_\_ Cu. Ft.

Dry Hole \_\_\_\_\_

Abandoned \_\_\_\_\_

Date

FEB 5 1941 19S. J. LEWIS Scout