

KANSAS

Ellis


Form 51-5M-7-39-Palace

Section 6 Township 11 Range 17-W

Well No. #3 Henderson "B"

Company Dickey Oil

NORTH Burnett So. Pool

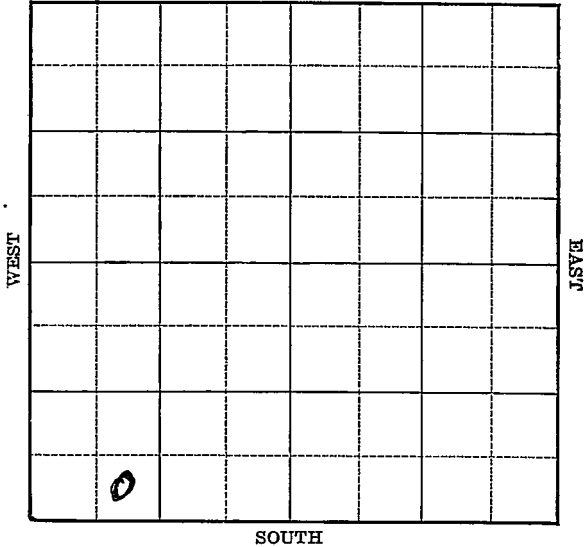

ELLIS

KANSAS

Map No. 71 Sec. 6 Twp. 11 R. 17W

Well No. 3 Henderson "B"

Dickey Oil Company

Contractor

FIRST REPORT

SE SW SW

Ft. from N. Line

330 Ft. from S. Line

Ft. from E. Line

990 Ft. from W. Line

SECTION PLAT

BURNETT SOUTH POOL

Location _____

Rig up _____

Drilling and Remarks:

RIGGING UP ROTY.

RECORD

Cased _____ in., _____ ft.

Sand _____

Gas _____

Oil _____

Total Depth _____

PRODUCTION

1st 24 hrs. Nat. _____

1st 24 hrs. after shot _____

Gas _____ Cu. Ft.

Dry Hole _____

Abandoned _____

Date

MAY 8 1940 19

S. J. LEWIS

Scout

Ellis

KANSAS

Map No. 71 Sec. 6 Twp. 11 R. 17W

Well No. 3 Henderson "B"

Dickey Oil Company

Contractor

COMPLETED

SE SW SW

 Ft. from N. Line

330 Ft. from S. Line

 Ft. from E. Line

990 Ft. from W. Line

SECTION PLAT

BURNETT SOUTH POOL

Location

Rig up

Drilling and Remarks:

at 3510

7" @ 3510

2000 acid

Pump 386 P.S.

RECORD

Cased in., ft.

Sand

Gas

Oil

Total Depth 3518

PRODUCTION

1st 24 hrs. Nat.

1st 24 hrs. after shot

Gas Cu. Ft.

Dry Hole

Abandoned

Date

JUN 12 1940 19

S. J. LEWIS Scout