

KANSAS


Ellis

Section 6 Township 11 Range 17-W

Well No. #1 Henderson "B"

Company Dickey Oil

NORTH Burnett South Pool

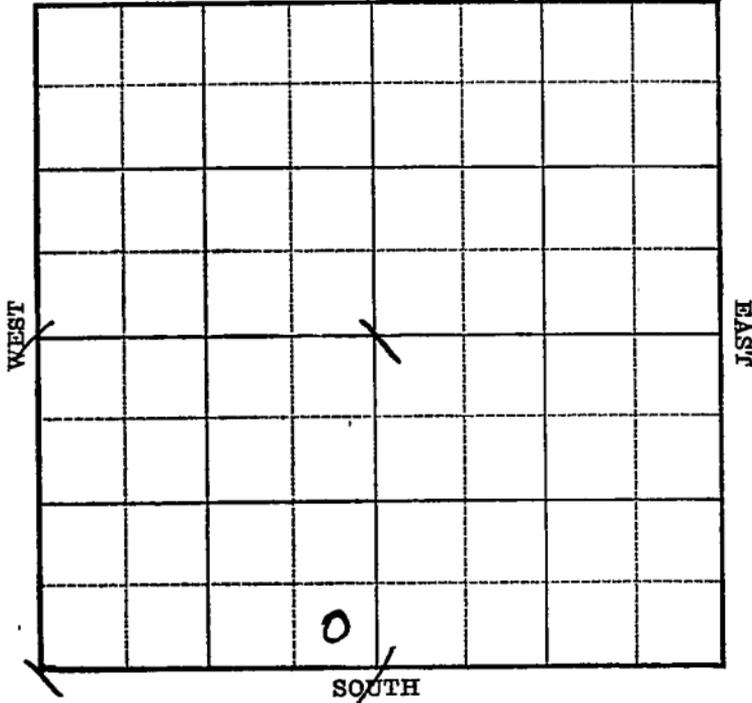

Sec. 6 Twp. 17 R. 17-W

Well No. #1 Henderson "B" Farm

Dickey Oil Company

(South Burnett)


_____ Ft. from N. Line

330 Ft. from S. Line

330 Ft. from E. Line

_____ Ft. from W. Line

Elev. 1923

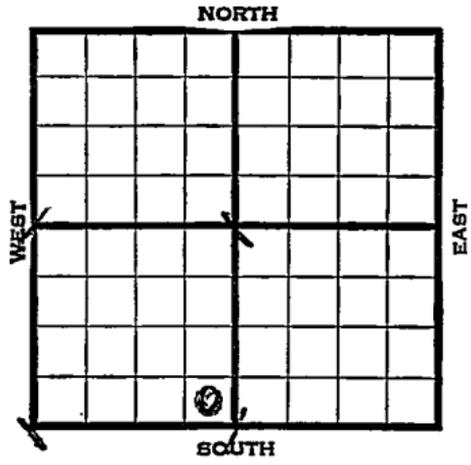

1939	REPORT
5/24	R.O.G.
6/1	Rig.
6/8	15" - 75'
-	Drlg. 260'
6/16	Anhy 1151' 10" - 1164' WOC.
6/23	Drlg. 3335'
6/29	Arb. 3471' 7" - 3471'
:	T.D. 3473' 3000' oil 4 hours.
7/5	Arb. 3471'
:	7" - 3471'
:	T.D. 3473'
:	2000 acid.
:	Depthograph potential 7078 bbls.
:	Maximum 3500 bbls.
:	COMPLETED
:	
:	
:	
:	
:	

Map No. 71 Sec. 6 Twp. 11 R. 17W

Well No. 1 Henderson "B"


Dickey Oil Company

Contractor

FIRST REPORT

SECTION PLAT

SE SW

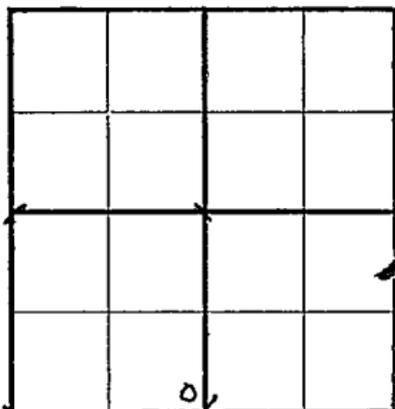

_____ Ft. from N. Line

330 Ft. from S. Line

330 Ft. from E. Line

_____ Ft. from W. Line

BURNETT SOUTH POOL

Location _____

Rig up _____

Drilling and Remarks:

ROG

RECORD

Cased _____ in., _____ ft.

Sand _____

Gas _____

Oil _____

Total Depth _____

PRODUCTION

1st 24 hrs. Nat. _____

1st 24 hrs. after shot _____

Gas _____ Cu. Ft.

Dry Hole _____

Abandoned _____

Date

MAY 24 1939 19 _____ S. J. LEWIS Scout

Ellis

KANSAS

Map No. _____ Sec. 6 Twp. 11 R. 17W

Well No. 1 Henderson "B"

Dickey Oil Company

Contractor _____

COMPLETED

SECTION PLAT

SE SW

_____ Ft. from N. Line

330 Ft. from S. Line

330 Ft. from E. Line

_____ Ft. from W. Line

BURNETT SOUTH POOL

Location _____

Rig up _____

Drilling and Remarks:

Ce & 3471

7" @ 3471

2000 acid

Depthograph P & T

7028

Maximum 3500

RECORD

Cased _____ in., _____ ft.

Sand _____

Gas _____

Oil _____

Total Depth 3473

PRODUCTION

1st 24 hrs. Nat. _____

1st 24 hrs. after shot _____

Gas _____ Cu. Ft.

Dry Hole _____

Abandoned _____

Date

JUL 5 1939 19

S. J. LEWIS

Scout