


Section 6 Township 11 Range 17W

Well No. #2 Gumble


Company Harry Gore

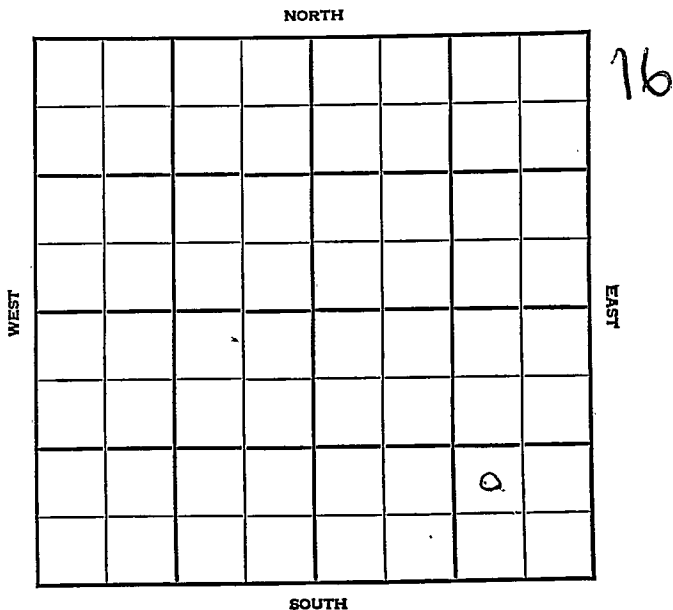

Sec. 6 Twp. 11 R. 17W

Well No. #2 Gumble Farm
Harry Gore Company
Burnett

 Ft. from N. Line
990 Ft. from S. Line
990 Ft. from E. Line
 Ft. from W. Line

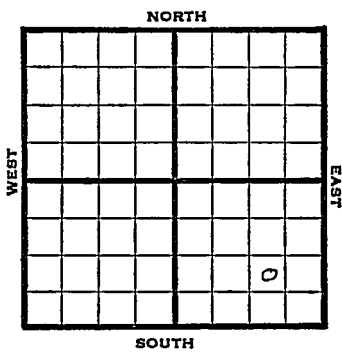

NW SE SE

1948 Elev. 1949' REPORT

6/1 Anhy. 1194
Drlg. 1197'

6/9 8" @ 1197'
Drlg 3148'

6/16 Arbuckle 3497'
TD 3498'
5" @ 3497'
RUST

6/23 TD 3502'
Pump 10 bbls oil PH 12 hrs.

6/30 Arbuckle 3497'
5" @ 3497'
Pump 286 oil Pot.
Gr. 36°
TD 3502'

COMPLETED

Map No. _____ Sec. 6 Twp. 11 R. 17W

Well No. 2 Gumble

Harry Gore Company

FIRST REPORT Contractor

NW SE SE

SECTION PLAT

_____ Ft. from N. Line

990 Ft. from S. Line

990 Ft. from E. Line

_____ Ft. from W. Line

			o

Ellis County

Location _____

Rig up _____

Drilling and Remarks:

Anhy 1194

drlg. 1197

RECORD

Cased _____ in., _____ ft.

Sand _____

Gas _____

Oil _____

Total Depth _____

PRODUCTION

1st.24 hrs. Nat. _____

1st 24 hrs. after shot _____

Gas _____ Cu. Ft.

Dry Hole _____

Abandoned _____

Date

JUN 1 1948 19

S. J. LEWIS

Scout

