

KANSAS

Ellis


Form 51-5M-7-39-Palace

Section 6 Township 11 Range 17-W

Well No. #2 Henderson "B"

Company Dickey Oil

NORTH Burnett South Pool

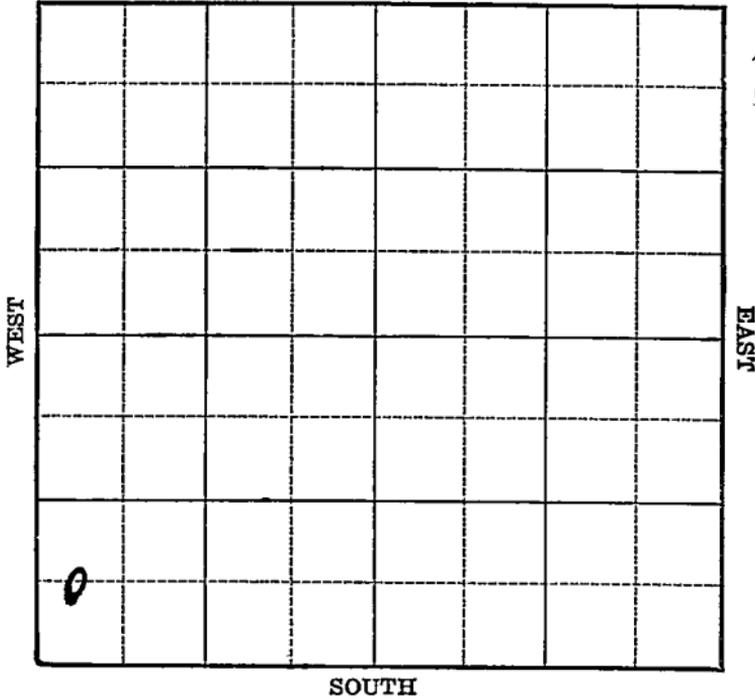

Map No. '71 Sec. 6 Twp. 11 R. 17WWell No. 2 Henderson "B"Dickey Oil

Company

Contractor

FIRST REPORT**SECTION PLAT****C W L SW SW**

_____ Ft. from N. Line

660 Ft. from S. Line

_____ Ft. from E. Line

330 Ft. from W. Line**BURNETT SOUTH POOL**

Location _____

Rig up _____

Drilling and Remarks:

Cellar & Ponds**RECORD**

Cased _____ in., _____ ft.

Sand _____

Gas _____

Oil _____

Total Depth _____

PRODUCTION

1st 24 hrs. Nat. _____

1st 24 hrs. after shot _____

Gas _____ Cu. Ft.

Dry Hole _____

Abandoned _____

Date

APR 10 1940 19S. J. LEWIS Scout

Map No. 71 Sec. 6 Twp. 11 R. 17W

Well No. 2 Henderson "B"

Dickey Oil Company

Contractor

COMPLETED

C W L SW SW

_____ Ft. from N. Line

660 Ft. from S. Line

_____ Ft. from E. Line

330 Ft. from W. Line

BURNETT SOUTH POOL

SECTION PLAT

Location _____

Rig up _____

Drilling and Remarks:

Cor. 3487
7" @ 3487
3000 acid
Depthograph 28
14 1/2

RECORD

Cased _____ in., _____ ft.

Sand _____

Gas _____

Oil _____

Total Depth 3493

PRODUCTION

1st 24 hrs. Nat. _____

1st 24 hrs. after shot _____

Gas _____ Cu. Ft.

Dry Hole _____

Abandoned _____

Date

MAY 29 1940 19

S. J. LEWIS Scout