

KANSAS

Form 51-5M-7-40-Palace


Ellis

Section 6 Township 11 Range 17-W

Well No. #5 Henderson "B"

Company Dickey Oil

NORTH Bemis Pool

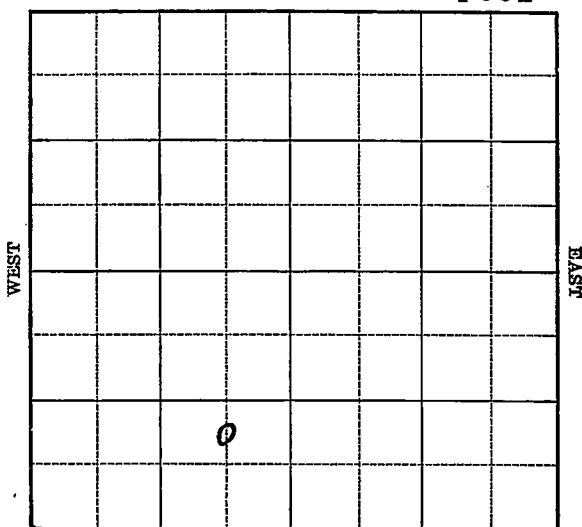

17

Map No. 71 Sec. 6 Twp. 11 R. 17WWell No. 5 Henderson "B"

Dickey Oil

Company

Contractor

FIRST REPORT
C N L SE SW

SECTION PLAT

	o		

 Ft. from N. Line990 Ft. from S. Line660 Ft. from E. Line Ft. from W. Line

BEMIS POOL

Location Rig up

Drilling and Remarks:

Derrick

RECORD

Cased in., ft.Sand Gas Oil Total Depth

PRODUCTION

1st 24 hrs. Nat. 1st 24 hrs. after shot Gas Cu. Ft.Dry Hole Abandoned

Date

DEC 11 1940 19S. J. LEWIS Scout

