

KANSAS


Form 51-5M-4-36-Palace

Ellis

Section 6 Township 11 Range 19W

Well Number #1 Armbrister

Company J.E. Trigg et al

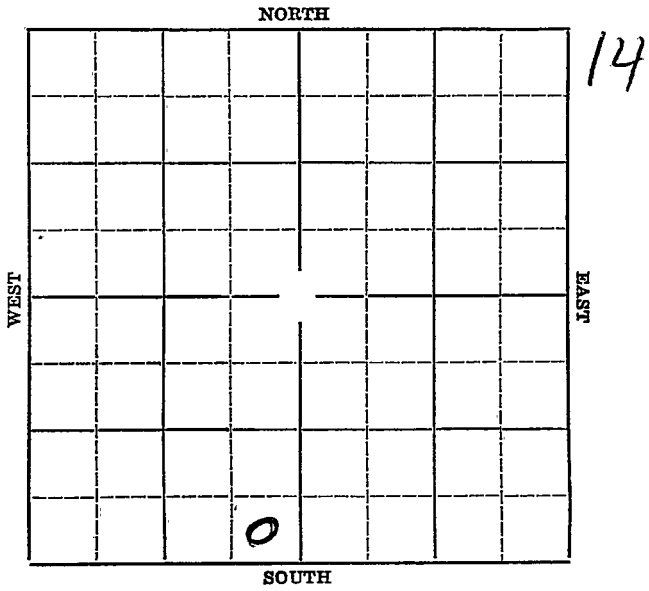

Map No. **KANSAS** Sec. **6** Twp. **11** R. **19W**

Well No. **#1 Armbrister** Farm

J.E. Trigg et al Company


_____ Ft. from N. Line

330' Ft. from S. Line

330' Ft. from E. Line

_____ Ft. from W. Line

Elev. 2130

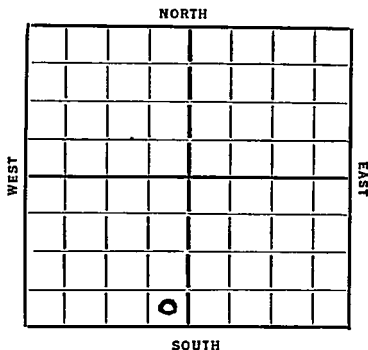

Date **1936**

REPORT

5/20 Cellar.

5/28 125'. W.O.C.

6/4 Shut down.

6/11--

7/8/36-Sil. 3763'. H.F.W.

T.D. 3770'.

D & R

ABANDONED

Map No. 70 Sec. 6 Twp. 11 R. 19

Well No. 1 Armbrister

J. E. Trigg & Co. Company
Contractor

SECTION PLAT

_____ Ft. from N. Line

330 Ft. from S. Line

330 Ft. from E. Line

_____ Ft. from W. Line

FIRST REPORT

Location _____

Rig up _____

Drilling and Remarks:

O & H

RECORD

Cased _____ in., _____ ft.

Sand _____

Gas _____

Oil _____

Total Depth _____

PRODUCTION

1st 24 hrs. Nat. _____

1st 24 hrs. after shot _____

Gas _____ Cu. Ft.

Dry Hole _____

Abandoned _____

Date

Jan 10 1900 19

S. J. LEWIS

Scout

Map No. 70 Sec. 6 Twp. 11 R. 19W

Well No. 1 Brubaker

J E Trigg & Co Company
J Contractor

SECTION PLAT

_____ Ft. from N. Line
330 Ft. from S. Line
330 Ft. from E. Line
_____ Ft. from W. Line

ABANDONED

Location _____

Rig up _____

Drilling and Remarks:

Oil 3763
HFV.
J & A

RECORD

Cased _____ in., _____ ft.
Sand _____
Gas _____
Oil _____
Total Depth 3770

PRODUCTION

1st 24 hrs. Nat. _____
1st 24 hrs. after shot _____
Gas _____ Cu. Ft.
Dry Hole _____
Abandoned _____

Date

JUL 8 1936 19

S. J. LEWIS Scout