

Ellis

KANSAS

6

11

19W

SECTION \_\_\_\_\_ TOWNSHIP \_\_\_\_\_ RANGE \_\_\_\_\_

WELL NO. #1 Keller

COMPANY Martin Oil

NORTH

				0			

WEST

EAST

SOUTH



Ellis

KANSAS


SEC.	6	TWP.	11	R.	19W
------	---	------	----	----	-----

WELL NO. #1 Keller FARM

COMPANY Martin Oil

CONTRACTOR Walters  
Jacob

\_\_\_\_\_ FT. FROM N. LINE  
 \_\_\_\_\_ FT. FROM S. LINE  
 \_\_\_\_\_ FT. FROM E. LINE  
 \_\_\_\_\_ FT. FROM W. LINE

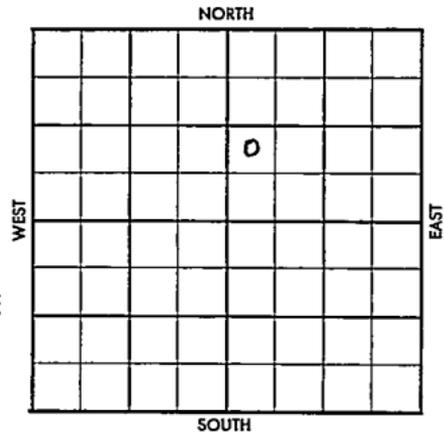

NW SW NE

1956	ELEVATION	REPORT
------	-----------	--------

9-5	Spud 9-1-56 8" @ 195/150 Drlg 1246  <p style="text-align: center;">ABANDONED</p>
-----	--

County Ellis Elev. \_\_\_\_\_  
 Sec. 6 Twp. M Rgs. 19W  
 Company Martin Oil  
 FarmName Keller No. 1

TOPS	DEPTH	LOG	DATUM
Anb.			
Tp.			
H.			
Tr.			
Dg.			
Bl.			
L.			
K.C.			
B.K.C.			
Ce.			
C.			
M.			
M.			
K.			
Mz.			
Mo.			
V.			
S.			
S.			
A.			
R.			
PE.			
G.			
T.D.			

Loc. in Sec. NW SW NE  
 Geol. \_\_\_\_\_  
 Contr. Walters  
 Pool Jacob  

	o	

**FIRST REPORT**  
 SEP 5 '56

Date Comm. 9-1-56  
8" @ 195/150 drlg. 1246

*(Handwritten scribbles)*

REV. 8 JAN

\*287 81

Co.  
 Use.  
 No.  
 Sec.  
 T.  
 R.

Co.

County Ellis Elev. 111'  
 Sec. 6 Twp. 19N Rgs. 19W  
 Company Martin Oil  
 FarmName Keller No. 1

TOPS	DEPTH	LOG	DATUM	Loc. in Sec.
Anh. <u>1</u>	<u>1490</u>			NW SW NE
Top. <u>1</u>	<u>3126</u>			
H. <u>✓</u>	<u>3347</u>			
Tr.	<u>3368</u>			
Dg.				
Bl.				
L.	<u>3384</u>			Geol.
K.C.				Contr.
B.K.C.	<u>3595</u>			<u>Walters</u>
Ce. <u>Marm</u>	<u>3636</u>			Pool
C.	<u>3642</u>			<u>Jacob</u>
M.				
M.				
K.				
Mz.				
Mo.				
V.				
S.	<u>3718</u>			
S.				
A.	<u>3734</u>			
R.				
PE.				
G.				
TD.	<u>3750</u>			

Lse.


**ABANDONED**  
SEP 12 '56

No.

Date Comm. 9-1-56

8" @ 195/150 drlg. 1246 SEP 12 '56

Sec.

*D & A.*

T.

R.