

DX 78-1

Ellis

KANSAS

Section 6 Township 11 Range 18 W

Well No. # 1 Gasaway

Company Murfin Drlg.

NORTH

				0					

10


WEST

EAST

SOUTH

SEC.	TWP.	R.
6	11	18 W
WELL NO.		
# 1 Gasaway		FARM
COMPANY		
Murfin Drlg.		
CONTRACTOR		
Murfin		

330 Ft. from N. Line
 _____ Ft. from S. Line
 _____ Ft. from E. Line
 330 Ft. from W. Line

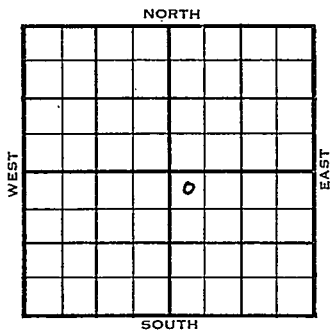

NW NW SE

1954	ELEVATION	REPORT
	1940'	

8/11 MIR

8/25 Spud 8-10-54
 D&A
 TD 3587'
 8-5/8" @ 205'
 Anhy 1290', Heeb 3167', KC 3211'
 DST 3554-84', opn 1 hr., rec. 13' mud,
 180#
 Cong 3460'
 DST 3462-75', opn 1 hr., rec. 3' wtry
 mud, Off
 Arb. 3573' VSSO
 TD 3585'
 Schl Tops: Heeb 3169'; Dodge 3186',
 Lans 3210', Cong 3455', Simp 3505',
 Arb. 3547'
 TD 3587'
 D&A

ABANDONED

County Ellis State Kansas

Sec. 6 (Blk. Twp.) 11 (Sur. Rge.) 18W Map No.

Operator Murfin Drlg.

Well No. 1 Farm Gasaway

Elev. _____ Location NW NW SE

FIRST REPORT											

330 Ft. From N Line SE

330 Ft. From W Line Quarter

Ist. Report AUG 11 1954

Completion _____

Remarks Murfin - Contr.

Spudding Date _____

Drlg. Data _____

M I R

County Ellis State Kansas

Sec. 6 (Blk.) 11 (Sur.) 18W Map No.

Operator Murfin Drlg.

Well No. 1 Farm Gasaway

Elev. 1940 Location NW NW SE

ABANDONED									

330 Ft. From N Line SE

330 Ft. From W Line Quarter

Ist. Report

Completion AUG 25 1954

Remarks

Murfin Drlg. - Contr.

Spudding Date 8-10-54

Drlg. Data D & A TD 3587

8 5/8" @ 205 Anhy 1290 Heeb. 3167

KC 3211 DST 3554-84 open 1 hr. Rec.

13' mud 180# Cong. 3460 DST 3462-75

open 1 hr. Rec. 3' wtry mud 0#

Arb. 3573 VSSO TD 3585

SCHLUMBERGER TOPS:

Heeb. 3169 Dodge 3186 Lans. 3210

Cong. 3455 Simp. 3505 Arb. 3547

TD 3587

D & A

FABEN GILSTRAP