


Section 6 Township 11 Range 20W

Well No. #2 Richards

Company Magnolia Pet.

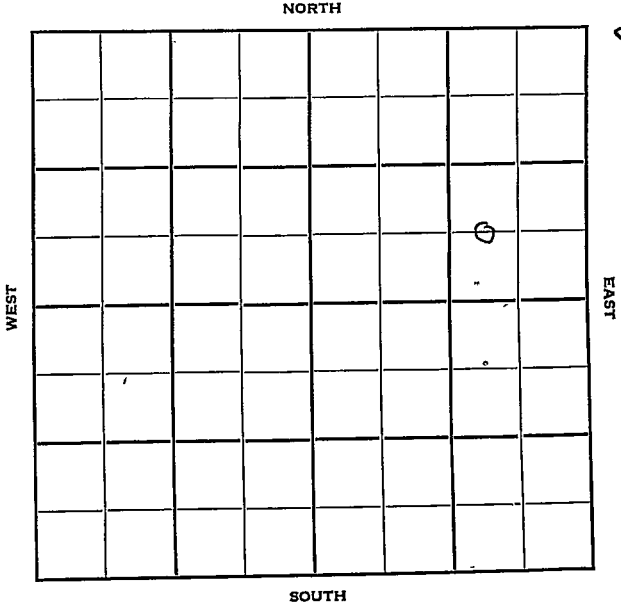

Ellis

KANSAS

Sec. 6 Twp. 11 R. 20W

Well No. #2 Richards Farm

Magnolia Pet. Company

Contractor

Mendota Pool


Ft. from N. Line

660 Ft. from S. Line

920 Ft. from E. Line

Ft. from W. Line

C W L S E N E

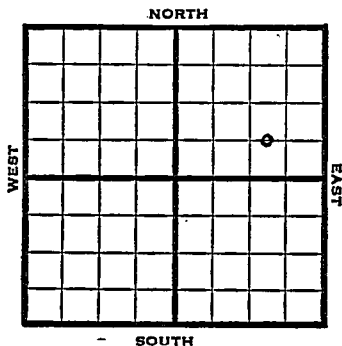

1952 Elev. 2059 REPORT

10/1 Spud 9-26-52
8" @ 195
Drlg. 1760

10/8 Heeb 3311, Lans 3346
drlg. 3440'

10/15 Arb 3672-75 RTD
5" @ 3673
CO to 3675, B/1 GOPH
Drlg. deeper 3677 TD, B/4 GOPH

10/22 DD 3679', B/4 galoph 1000A
25 galoph 2 hrs., 2000^A, 9 galo
& 9 galwph DD 3684' PB 3675
Set Retainer 3851' sq

10/29 NR

11/5 CO 3684 3 galo & 4 galwph
2000 A 30 galo & 4 galwph 1000 A

11/12 Spud 9-26-52 Oil well TD 3684'
8" @ 195 Heeb 3311' Lans. 3346'
Arb. 3672' TD 3675' 5" @ 3673
CO to 3675' B/1 GOPH DD 3677
B/4 BOPH DD 3679' B/4 GOPH
1000 A 25 GOPH 2000 A 9 GO
9 GWPB DD 3684' PB 3675'

OVER

1952
11/12

(Information continued)
SP 3581' CO to 3684' 3 GO 4 GWPH
2000 A 30 GO 4 GWPH 1000 A
P & F/4 BO 4 hr.
Comp. 36 BOPD

COMPLETED

