


Section 6 Township 11 Range 23W

Well No. 1 Walker

Company Walbers Drlg.

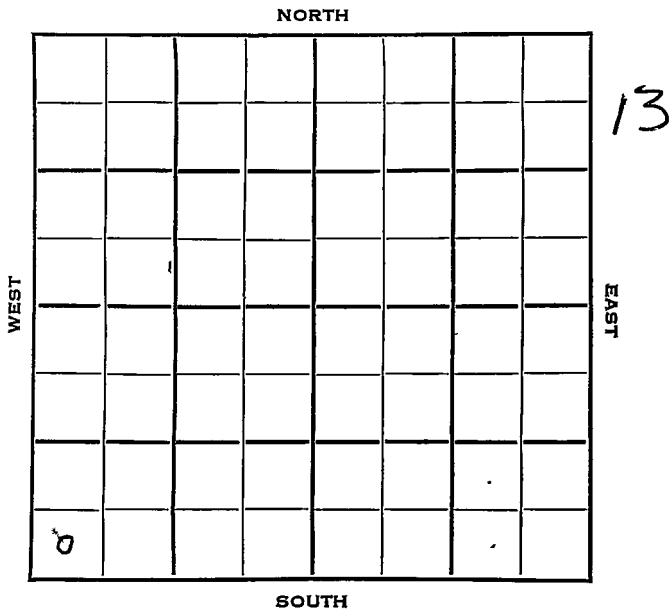

Trego

SEC.	TWP.	R.	KANSAS
6	II		23W ✓

WELL NO.

#1 Walker

FARM

COMPANY

Walters Drlg.

CONTRACTOR

Walters Drlg.

Wildcat.

Ft. from N. Line


330

Ft. from S. Line

Ft. from E. Line

330

Ft. from W. Line

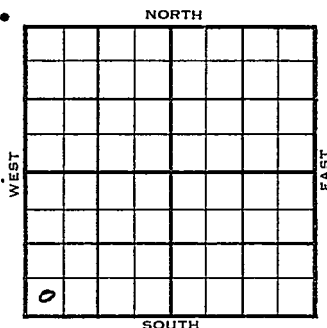

SW SW SW
Derby acreage.

	ELEVATION	REPORT
1954	2294'	

4/21

Spud 4-15-54
8" @ 196'
Anhy 1884'
Drlg 2053'

5/5

Spud 4-15-54
D & A
TD 4395'
8" @ 196'
Anhy 1884', Top 3399', Heeb 3624'
Tor 3644', Lans 3660', b KC 3896'
Marm 4029'
DST 4030'-46' opn 1 hr, rec 15' Mud
250# Cong 4187', Miss 4228', Kh. 4240'
Viola 4261', Simp 4361', Arb 4372'
TD 4395'
D & A

ABANDONED

County Trego State KansasSec. 6 (Blk.) 11 (Sur.) 23W Map No.Operator Walters Drlg.Well No. 1 Farm WalkerElev. 2294 Location SW SW SW

0							

330 Ft. From S Line SW330 Ft. From W Line Quarter1st. Report APR 21, 1954

Completion

Remarks Derby - acreageWalters Drlg. - Contr.Spudding Date 4-15-54Drlg. Data Wildcat8" @ 196 Anhy 1884 drlg. 2053

