


Trego

KANSAS

SECTION 6 TOWNSHIP 11S RANGE 24W

WELL NO. #1 Berg

COMPANY Murfin, Rains & Williamson

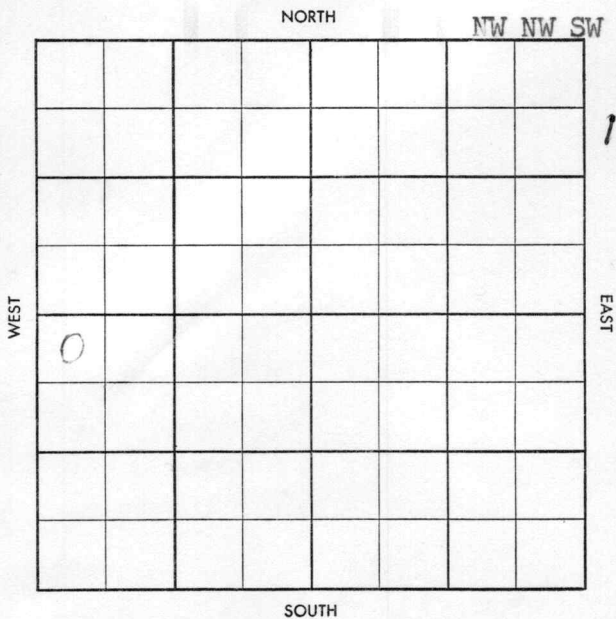

Twp. Pool

WILDCAT

S-513-B

County Trego Elev. _____
 Sec. 6 Twp. 11 Rge. 24W
 Company Murfin, Rains & Williamson
 Farm Name Berg No. 1

TOPS	DEPTH	LOG	DATUM
Anh.			
Tp.			
H.			
Tr.			
Dg.			
B.L.			
L.			
K.C.			
B.K.C.			
Ce.			
C.			
M.			
M.			
K.			
Mz.			
Mq.			
V.			
S.			
S.			
A.			
R.			
Pf.			
G.			
T.D.			

Loc. in Sec. _____


NW NW SW

Geol. _____

Contr. _____

Pool _____

Wildcat

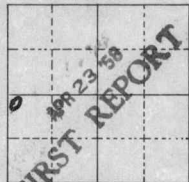

Date Comm. (Phillips - Ac)

Location - BKC tes(Imperial & Kaiser - DHM)

Co.

Lse.

No.

Sec.

T.

R.

Twp. X Pool

Co. Facet X

S-513-B

County Trego Elev. 23960F 2379R
 Sec. 6 Twp. 11 Rge. 24W
 Company Murfin, Rains & Williamson
 Farm Name Berg No. 1

TOPS	DEPTH	LOG	DATUM
Anh.	<u>2035</u>		
Tp.			
H.	<u>3727</u>	<u>3728</u>	
Tr.	<u>3749</u>	<u>3749</u>	
Dg.			
B.L.			
L.	<u>3763</u>	<u>3765</u>	
K.C.			
B.K.C.		<u>4002</u>	
Ce.			
C.			
M.			
M.			
K.			
Mz.			
Mq.			
V.			
S.			
S.			
A.			
R.			
Pf.			
G.			
T.D.	<u>4020</u>		

Loc. in Sec. NW NW SW

Geol. Co tools

Pool Wildcat

ABANDONED

MAY 21 '58

Date Comm. 5-8-58 (Phillips - Ac)

Location - BKC test Imperial & Kaiser - DHM)

APR 30 '58 MURT MAY 7 '58 MAY 14 '58 8" 208/170

3735 DST 3917-80 90" 155' WM

FPO-180 BHP 1260/20" Log

DoA