


Section.....7.....Township.....11.....Range.....16-W

Well Number.....#1 Clause.....


Company.....Gulf.....

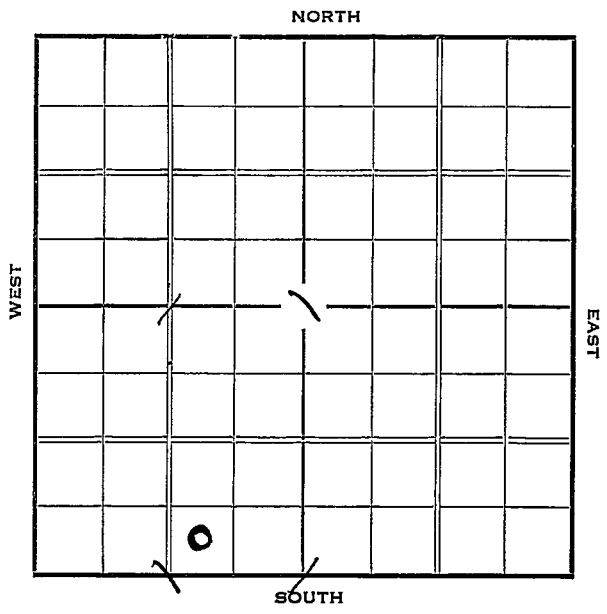

Sec. 7 Twp. 11 R. 16-W

Well No. #1 Clause Farm _____
Gulf Company

_____ Ft. from N. Line
330 Ft. from S. Line
990 Ft. from E. Line
 _____ Ft. from W. Line
 Elev. 1796

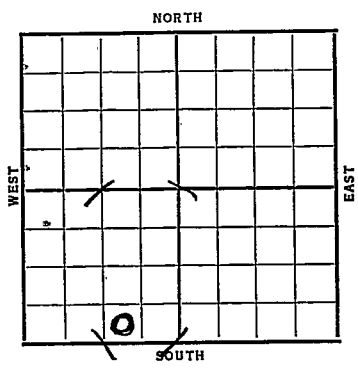

Date	REPORT
1937	
7/21	B.R.R.
7/30	15" @ 168'. WOC.
8/6	Anhy 982'. 10" @ 1002'. WOC.
8/13	Drl g. 2860'.
8/20	Sil. & 6" @ 3324'.
	T.D. 3327'. RUST.
8/28	" " " "
9/3	T.D. 3336'. 3000' oil 24
	hrs. 2000 acid.
	Pump 234 bbls. oil 4 hrs.
	SD for tanks.
	OVER

1937 ..

9/8 6" @ 3334'.8

Silicious 3324'.

T.D. 3336'.

2000 acid.

P. 291.49 bbls. 4 hrs.

P. 314.30 bbls. 4 hrs.

Potential 1749 bbls. .

COMPLETED

Ellis

Map No. 71 Sec. 7 Twp. 11 R. 16 W

Well No. 1- Clause

Gulf Company
Contractor

FIRST REPORT SECTION PLAT

_____ Ft. from N. Line

330 Ft. from S. Line

990 Ft. from E. Line

_____ Ft. from W. Line

	X	X	
	X	X	

Location _____

Rig up _____

Drilling and Remarks: *BRR*

RECORD

Cased _____ in., _____ ft.

Sand _____

Gas _____

Oil _____

Total Depth _____

PRODUCTION

1st 24 hrs. Nat. _____

1st 24 hrs. after shot _____

Gas _____ Cu. Ft.

Dry Hole _____

Abandoned _____

Date

JUL 21 1929

H. D. Hatfield Scout

Map No. 71 Sec. 7 Twp. 11 R. 16W

Well No. 1- clause

bulk oil Company _____

Contractor _____

COMPLETED

SECTION PLAT

	0		

_____ Ft. from N. Line

330 Ft. from S. Line

990 Ft. from E. Line

_____ Ft. from W. Line

Location _____

Rig up _____

Drilling and Remarks:

2000 acid

P. 291.49 4 hrs
314.30 4 hrs

Potential
1749 bbls

RECORD

Cased 6 in., 333 1/4 ft.

Sand Silicious 3324

Gas _____

Oil _____

Total Depth 3336

PRODUCTION

1st 24 hrs. Nat. _____

1st 24 hrs. after shot _____

Gas _____ Cu. Ft.

Dry Hole _____

Abandoned _____

Date

SEP 8 1937 19

H. D. Hatfield

Scout