Ellis KANSAS

7 11S 16W


SECTION TOWNSHIP RANGE

#1 M.C. Fees

WELL NO.

Musgrove Petr.

COMPANY

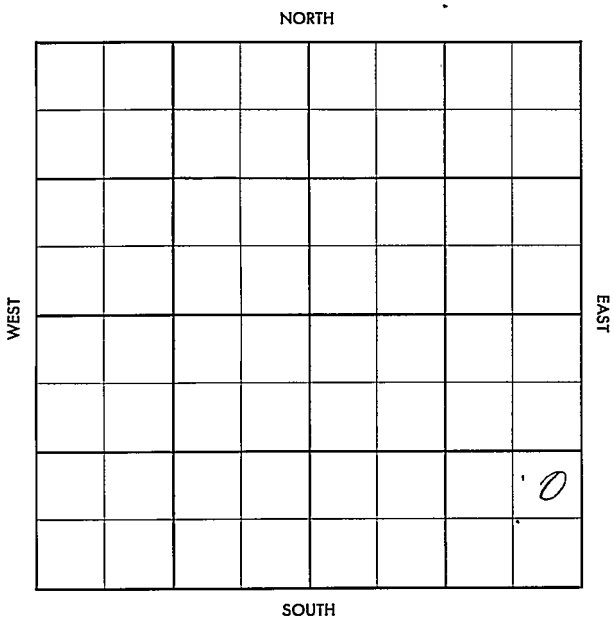

FORM 504-3 SUNRAY

FORM 513 SUNRAY

County Ellis Elev. 1864 DF

Sec. 7 Twp. 11S Rge. 16W

Company Musgrove Petroleum

FarmName M. C. Fees No. 1

TOPS	DEPTH	LOG	DATUM
Anh.			
T.P.			
H.			
Tr.			
Dg.			
Bl.			
L.			
K.C.			
B.K.C.			
Ce.			
C.			
M.			
M.			
K.			
Mz.			
Mo.			
V.			
S.			
S.			
A			
R.			
P€.			
G.			
T.D.			


Loc. in Sec. NE SE SE

DS - SE¼

Geol.

Contr. Co.

Pool Bemis Shutts

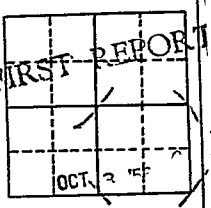

Date Comm. 9-29-56

8⅝ 1064 w/460; D 2480

FORM 515 SUNRAY

County Ellis Elev. 1861 DF

Sec. Twp. 11S Rge. 16W

Company Musgrove Petroleum

Farm Name M. C. Fees No. 1

TOPS	DEPTH	LOG	DATUM
Anh.			
Tp.	2995		
H.	3030		
Tr.	3051		
Dg.			
Bl.			
L.	3078		
K.C.			
B.K.C.	3315		
Ce.			
C.	3346		
M.			
M.			
K.			
Mz.			
Me.			
V.			
S.	3397		
S.			
A.	3434		
R.			
Pe.			
G.			
T.D.	3440		

Loc. in Sec. NE SE SE

DS - SE¼

Geol.

Contr. Co.

Pool Bemis Shutt

COMPLETE

NOV 23 '56

Date Comm. 8-29-56

8" 106# w/160; D 2480 OCT 10 '56 DST

3346-71 1st Pkr 1hr rec 40' MSW BHP 620 DST 3435-38 1hr 5' oil + 20' OCM BHP Failed DST 3435-40 1hr rec 5' Free oil + 45' HOCM + 10' Md BHP 1090 4½ @ 3440 OCT 17 '56

OCT 24 '56 Co OCT 31 '56 DD 3440½ Ma

5 3/4 Bo + 3/4 Bwph T&R OCT 7 '56

1 RS Pump NOV 13 '56 Pumping no test NOV 21 '56

FORM 513-1 SUNRAY

X Ph P. 29 Bopd + 35 % wtr
grav 27° corrected.
Arb. a. H. 3440 - 40½

7-11-16 new se se