

Ellis


KANSAS

SECTION 7 TOWNSHIP 11 RANGE 16 W

WELL NO. #1 Romine

COMPANY Gruenerwald

NORTH

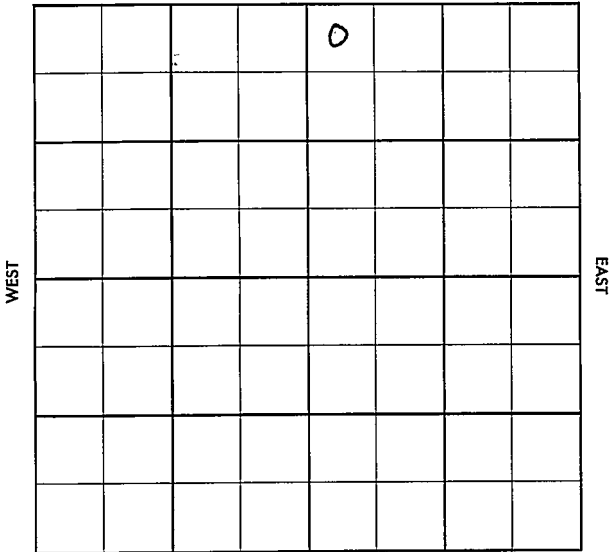

SOUTH

Ellis

KANSAS

SEC. 7	TWP. 11	R. 16W
-----------	------------	-----------

WELL NO. #1 Romine FARM

COMPANY Gruenerwald

CONTRACTOR Prije

Wildcat

_____ Ft. from N. Line


_____ Ft. from S. Line

_____ Ft. from E. Line

_____ Ft. from W. Line

NW NW NE

Mid-States FO

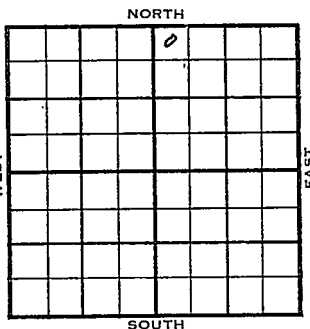

1955

ELEVATION
1869'

REPORT

10/2

M I R

11-16

Comm. 11-4-55
 10 3/8" @ 198/125
 D & A
 Tops: Anh. 1065
 Tp. 2789
 H. 3023
 Tr. 3044
 L. 3066
 B.K.C. 3308
 C. 3341
 S. 3441
 A 3454
 TD 3480'

ABANDONED

County Ellis Elev. _____
 Sec. 7 Twp. 11 Rge. 10E
 Company Cruenerwald
 Farm Name Domine No. 1

Co.

TOPS	DEPTH	LOG	DATUM	Loc. in Sec.
Anh.				
Tp.				NW NW NE
H.				
Tr.				
Dg.				
Bl.				
L.				
K.C.				Geol.
B.K.C.				Contr.
Ce.				
C.				Prime
M.				Pool
M.				
K.				
Mz.				Wildcat
Me.				
V.				
S.				
S.				
A.				
R.				
PE.				
G.				
TD.				

Lse.

FIRST REPORT

No.

Date Comm. Mid-States FO

Sec.

M T D

T.

R.

County Ellis Elev. 1869
 Sec. 7 Twp. 11 Rge. 16W
 Company Gruenerwald
 FarmName Romine No. 1

Co.

TOPS	DEPTH	LOG	DATUM
Anb.	1065		
TP.	2789		920
H.	3023		1154
Tr.	3044		1175
Dg.			
Bl.			
L.	3066		1197
K.C.			
B.K.C.	3308		1439
Ce.			
C.	3341		1472
M.			
M.			
K.			
Mz.			
Mq.			
V.			
S.	3441		1572
S.			
A.	3454		1585
R.			
PE.			
G.			
T.D.	3480		

Loc. in Sec. _____

NW NW NE

Geol. _____

Contr. _____

Prime

Pool _____

Wildcat

		0

ABANDONED

Loc.

No.

Sec.

T.

R.

Date Comm. 11-4-55 NOV 16 1955
10 3/8" @ 198/125

D & A