
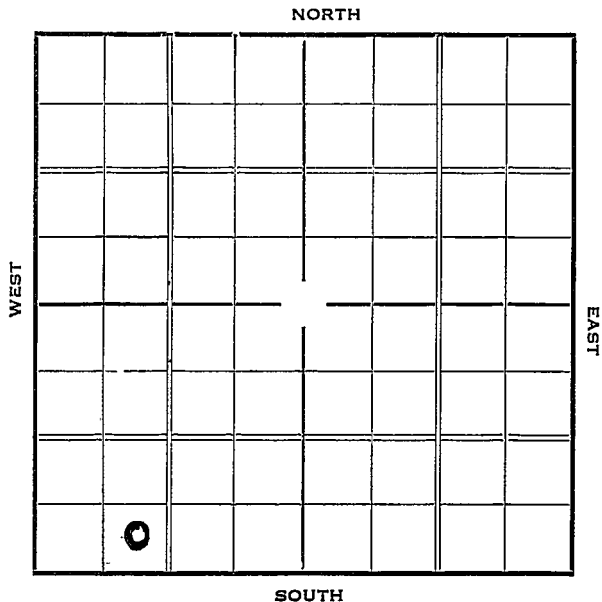


Section 7 Township 11 Range 16-W

Well Number 2 - Romine

Company Sinclair-Prairie

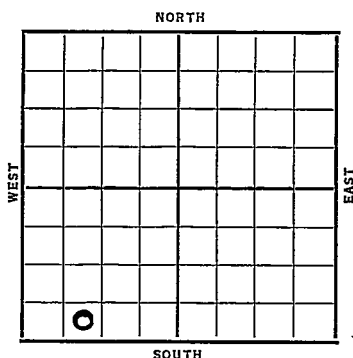

Sec. 7 Twp. 11 R. 16-WWell No. #2 Romine FarmSinclair-Prairie Company Ft. from N. Line330 Ft. from S. Line Ft. from E. Line990 Ft. from W. Line

Date	REPORT
1937	
5/19	Cellar
5/28	Reaming hole 120'.
6/4	15" @ 92'. Anhy 975'.
	9" @ 994'. WOC.
6/11	Drlg. 2156'.
6/19	Drlg. 3106'.
6/25	Simpson 3303'. 7" @ 3303'.
	T.D. 3305'. WOC.
7/2	T.D. 3315'. 2900' oil in 20
	hrs.
7/7	7" @ 3303'.
	Sil. 3307'.
	T.D. 3315'.
	Pot. 760 bbls.
	COMPLETED

Ellis KANSAS

Map No. 71 Sec. 7 Twp. 11 R. 16 ^WWell No. 2 RomineSinclair Prairie Company

Contractor

FIRST REPORT

____ Ft. from N. Line

330 Ft. from S. Line

____ Ft. from E. Line

990 Ft. from W. Line

SECTION PLAT

Location _____

Rig up _____

Drilling and Remarks:

Cellar

RECORD

Cased _____ in., _____ ft.

Sand _____

Gas _____

Oil _____

Total Depth _____

PRODUCTION

1st 24 hrs. Nat. _____

1st 24 hrs. after shot _____

Gas _____ Cu. Ft.

Dry Hole _____

Abandoned _____

Date

MAY 19 1937

H. D. Hatfield

Scout

Ellis KANSAS

Map No. _____ Sec. 7 Twp. 11 R. 16 WWell No. 2 - RosineSinclair Prairie Company

Contractor _____

COMPLETED

_____ Ft. from N. Line

330 Ft. from S. Line

_____ Ft. from E. Line

990 Ft. from W. Line

SECTION PLAT

Location _____

Rig up _____

Drilling and Remarks:

Pat. 760

RECORD

Cased 7 in., 3303 ft.Sand S11 3307

Gas _____

Oil _____

Total Depth 3315

PRODUCTION

1st 24 hrs. Nat. _____

1st 24 hrs. after shot _____

Gas _____ Cu. Ft.

Dry Hole _____

Abandoned _____

Date

JUL 7 1937 19 H. D. Hatfield Scout