


Section 7 Township 11 Range 17-W

Well No. #1 Henderson

Company Harry Gore
Burnett Pool

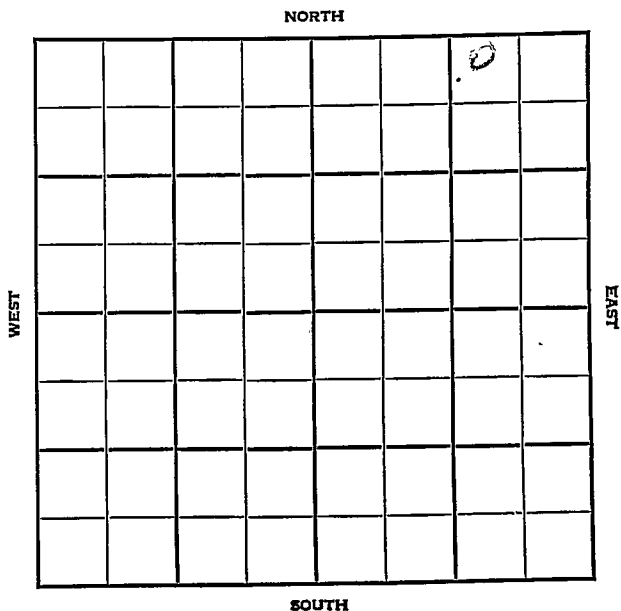

KANSAS

Ellis

11

R.

17W

Sec. 7 Twp. 11

Well No. #1 Henderson Farm

Harry Gore Company

Burnett Pool


330' Ft. from N. Line

Ft. from S. Line

990' Ft. from E. Line

Ft. from W. Line

NW NE NE

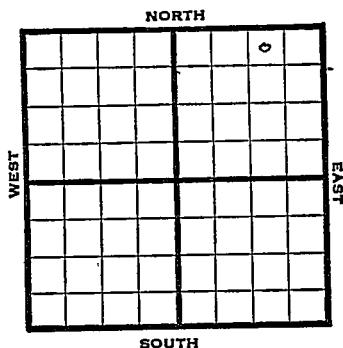

1948

Elev. 1879' REPORT

6/16

Drlg. 1033'

6/23

Drlg 2915'

6/29

Lansing 3104'
Simpson 3395'
Arbuckle 3429'
TD 3431'
5" @ 3431'
RUST

7/8

Arbuckle 3429'
5" @ 3431'
Pump 100 oil Pot
Gr. 36°
TD 3432'

COMPLETED

Burnett Pool

Map No. _____ Sec. 7 Twp. 11 R. 17W

Well No. 1 Henderson

Harry Gore

Company

FIRST REPORT

Contractor

NW NE NE

330 Ft. from N. Line

_____ Ft. from S. Line

990 Ft. from E. Line

_____ Ft. from W. Line

SECTION PLAT

			16

Ellis County

Location _____

Rig up _____

Drilling and Remarks:

drlg. 1033

RECORD

Cased _____ in., _____ ft.

Sand _____

Gas _____

Oil _____

Total Depth _____

PRODUCTION

1st 24 hrs. Nat. _____

1st 24 hrs. after shot _____

Gas _____

Cu. Ft.

Dry Hole _____

Abandoned _____

Date

JUN 16 1948

19

S. J. LEWIS

Scout

Burnett Pool

Map No. 71 Sec. 7 Twp. 11 R. 17WWell No. 1 Henderson


Harry Gore

Company

COMPLETE

Contractor

NW NE NE

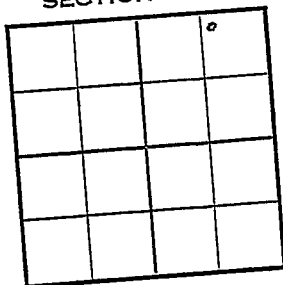E11879
SECTION PLAT330 Ft. from N. Line

Ft. from S. Line

990 Ft. from E. Line

Ft. from W. Line

Ellis County

Location

Rig up

Drilling and Remarks:

CR 84295" @ 8481Run 100 oil Box36° Gr

RECORD

Cased _____ in., _____ ft.

Sand _____

Gas _____

Oil ☒Total Depth 3432

PRODUCTION

1st 24 hrs. Nat. _____

1st 24 hrs. after shot _____

Gas _____ Cu. Ft.

Dry Hole _____

Abandoned _____

Date

JUL 8 1948 19

S. J. LEWIS Scout