


Section 7 Township 11 Range 17-W

Well No. #2 Henderson

Company Harry Gore

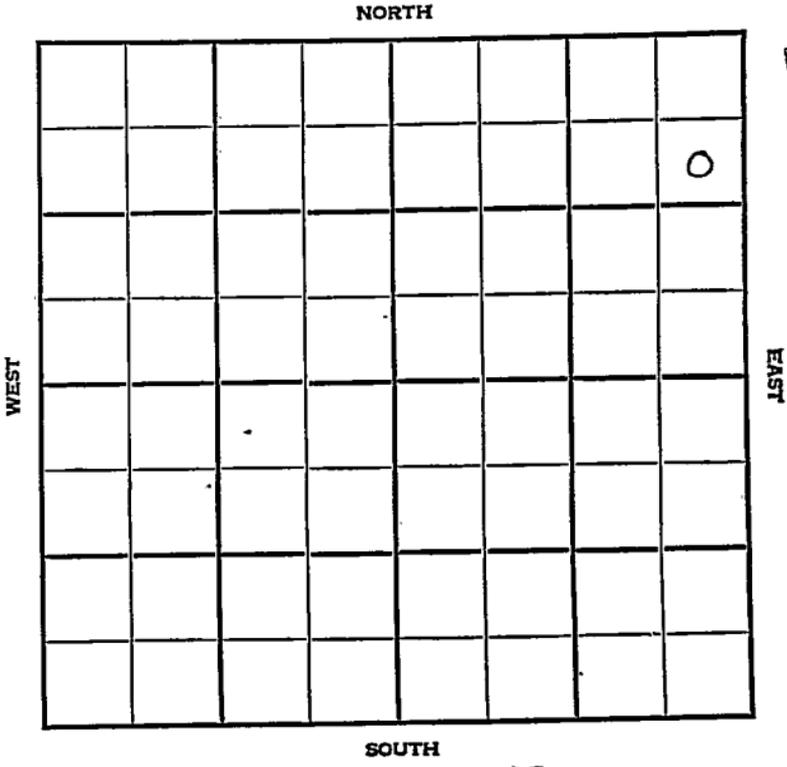

KANSAS

Ellis

Sec. 7 Twp. 11 R. 17W ✓

Well No. #2 Henderson Farm

Harry Gore Company


Burnett Pool

990' Ft. from N. Line

\_\_\_\_\_ Ft. from S. Line

330' Ft. from E. Line

\_\_\_\_\_ Ft. from W. Line

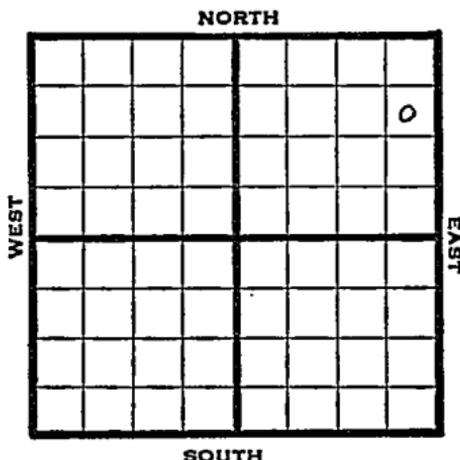

SE NE NE

1948

Eli 1870'

REPORT

- 6/16 Location
- 6/23 "
- 6/29 RUR
- 7/18 8" @ 1113
- 8 Drlg 2005
- 7/14 Drlg 3259'
- 7/21 "
- 7/28 Lansing 3191'
- Arb. 3412-14'
- TD 3414'
- 5" @ 3412 1400' oil 2½ hrs.
- 8/4 "
- 8/11 "
- 8/18 "
- 8/25 Arbuckle 3412
- 5" @ 3412'
- TD 3414'
- Pump 240' oil Pot
- 36° Gr.
- Comp

**COMPLETED**

Map No. \_\_\_\_\_ Sec. 7 Twp. 11 R. 17W

Well No. 2 Henderson

Harry Gore Company

**FIRST REPORT**

Contractor

SE NE NE

SECTION PLAT

990 Ft. from N. Line

\_\_\_\_\_ Ft. from S. Line

330 Ft. from E. Line

\_\_\_\_\_ Ft. from W. Line


Ellis County

Location X

Rig up \_\_\_\_\_

Drilling and Remarks:

RECORD

Cased \_\_\_\_\_ in. \_\_\_\_\_ ft.

Sand \_\_\_\_\_

Gas \_\_\_\_\_

Oil \_\_\_\_\_

Total Depth \_\_\_\_\_

PRODUCTION

1st 24 hrs. Nat. \_\_\_\_\_

1st 24 hrs. after shot \_\_\_\_\_

Gas \_\_\_\_\_ Cu. Ft.

Dry Hole \_\_\_\_\_

Abandoned \_\_\_\_\_

Date

JUN 16 1948 19

S. J. LEWIS Scout

Ellis County Kansas State

Map No. 71 Sec. 7 Twp. 11 R. 17W

Well No. 2 Henderson

Harry Gore Company

COMPLETE Contractor

SE NE NE

E. 1870 SECTION PLAT

									6

990 Ft. from N. Line

Ft. from S. Line

330 Ft. from E. Line

Ft. from W. Line

Burnett Pool

Remarks:

*cut 3412*

*5" @ 3412*

*WD 3414*

*Pump 240 oil Pt*

*36 3/4*

Date

AUG 25 1948

Scout

S. J. LEWIS