


Section 7 Township 11 Range 17-W

Well No. 2 Herndon

Company Dickey Oil

NORTH Semi-Wildcat

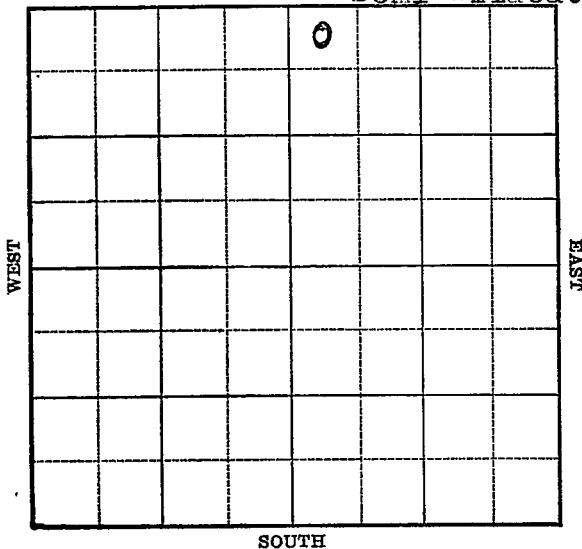

Sec. 7 Twp. 11 R. 17-W

Well No. #2 ~~Hornden~~ Henderson Farm

Dickey Oil Company


(Semi-Wildcat)

330 Ft. from N. Line

\_\_\_\_\_ Ft. from S. Line

\_\_\_\_\_ Ft. from E. Line

330 Ft. from W. Line

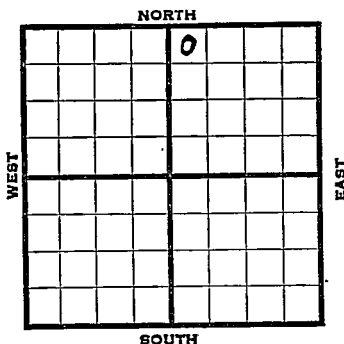

Elev. 1890

1939	REPORT
5/3	Cellar.
5/12	R.O.G.
5/19	15" - 80' Drlg. 952'
5/26	Anhy 1147' 10" - 1166' Drlg. 2395.
6/1	Drlg. 3380'
6/8	Arb. 3438'
	6" @ 3438' T.D. 3440' H.F.O. Tubing.
6/16	Potential 3850 bbls. Depthograph natural.
6/27	Arb. 3438'
	6" - 3438'
	T.D. 3440'
	Potential pump 3850 bbls.
	Depthograph 35,000
	Maximum 3500 bbls.
	COMPLETED

Map No. 71 Sec. 7 Twp. 11 R. 17W

Well No. 2 Herndon

Dickey Oil Company

Contractor

FIRST REPORT

SECTION PLAT

330 NW NE  
Ft. from N. Line

\_\_\_\_\_ Ft. from S. Line

\_\_\_\_\_ Ft. from E. Line

330 Ft. from W. Line

		o	

SEMI-WILDCAT

Location \_\_\_\_\_

Rig up \_\_\_\_\_

Drilling and Remarks:

**Cellar**

RECORD

Cased \_\_\_\_\_ in., \_\_\_\_\_ ft.

Sand \_\_\_\_\_

Gas \_\_\_\_\_

Oil \_\_\_\_\_

Total Depth \_\_\_\_\_

PRODUCTION

1st 24 hrs. Nat. \_\_\_\_\_

1st 24 hrs. after shot \_\_\_\_\_

Gas \_\_\_\_\_ Cu. Ft.

Dry Hole \_\_\_\_\_

Abandoned \_\_\_\_\_

Date

MAY 3 1939 19

S. J. LEWIS Scout

Map No. \_\_\_\_\_ Sec. 7 Twp. 11 R. 17W

Well No. 2 Henderson

Dickey Oil Company

Contractor

**COMPLETED**

NW NE

330 Ft. from N. Line

       Ft. from S. Line

       Ft. from E. Line

330 Ft. from W. Line

**SECTION PLAT**

		0	

**SEMI-WILD CAT**

Location \_\_\_\_\_

Rig up \_\_\_\_\_

Drilling and Remarks:

*Cor 3438.*  
*6" C 3438.*  
*Prod pump 3850*  
*Depthograph:*  
*3500*  
*Maxi 3500*

**RECORD**

Cased \_\_\_\_\_ in., \_\_\_\_\_ ft.

Sand \_\_\_\_\_

Gas \_\_\_\_\_

Oil \_\_\_\_\_

Total Depth 3440

**PRODUCTION**

1st 24 hrs. Nat. \_\_\_\_\_

1st 24 hrs. after shot \_\_\_\_\_

Gas \_\_\_\_\_ Cu. Ft.

Dry Hole \_\_\_\_\_

Abandoned \_\_\_\_\_

Date

JUN 21 1939

19

S. J. LEWIS

Scout