

KANSAS

Ellis


FORM 51 IOM 12-46 PETROL

Section 7 Township 11 Range 18-W

Well No. 1 Richard

Company Westgate-Greenland

Wildcat

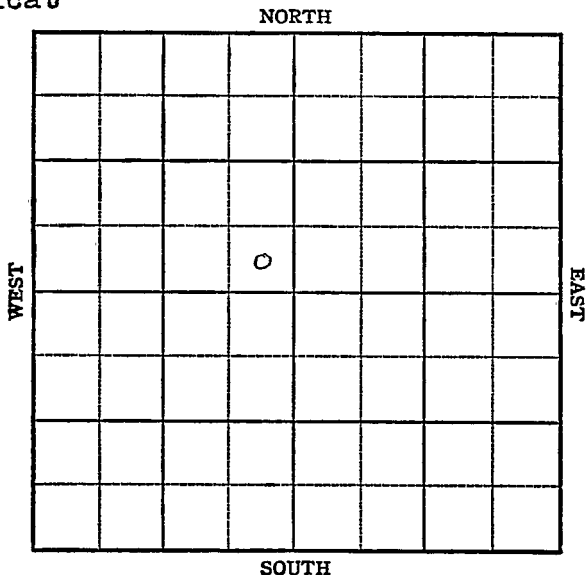

**KANSAS**

**Ellis**

Sec. 7 Twp. 11 R. 18W

Well No. #1 Richard Farm

Westgate-Greenland Company  
Wildcat


330 Ft. from N. Line

\_\_\_\_\_ Ft. from S. Line

\_\_\_\_\_ Ft. from E. Line

330 Ft. from W. Line

**NW SE**

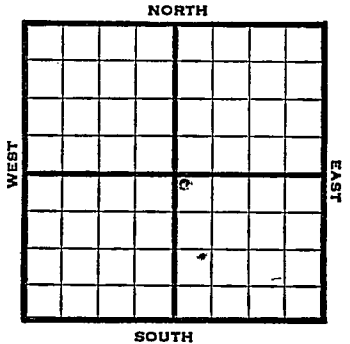

1947	Elev. 1932' REPORT
10/8	8" @ 210 WOC
10/15	Drlg. 2469'
10/22	Lansing 3204' Drlg. 3235'
10/29	Arbuckle 3559' TD 3613'
<b>ABANDONED</b>	

Map No. 71 Sec. 7 Twp. 11 R. 18W

Well No. 1 Richard

Westgate-Greenland Company

**ABANDONED**

Contractor

NW SE

*E 11922*  
SECTION PLAT

330 Ft. from N. Line

\_\_\_\_\_ Ft. from S. Line

\_\_\_\_\_ Ft. from E. Line

330 Ft. from W. Line

		0	

Ellis County

Location: \_\_\_\_\_

Rig up \_\_\_\_\_

Drilling and Remarks:

*See 10509*

**RECORD**

Cased \_\_\_\_\_ in., \_\_\_\_\_ ft.

Sand \_\_\_\_\_

Gas \_\_\_\_\_

Oil \_\_\_\_\_

Total Depth 3613

**PRODUCTION**

1st 24 hrs. Nat. \_\_\_\_\_

1st 24 hrs. after shot \_\_\_\_\_

Gas \_\_\_\_\_ Cu. Ft.

Dry Hole \_\_\_\_\_

Abandoned \_\_\_\_\_

Date

OCT 29 1947 19

S. J. LEWIS Scout

Map No. \_\_\_\_\_ Sec. 7 Twp. 11 R. 18W

Well No. 1 Richard

Westgate-Greenland Company

FIRST REPORT

Contractor

NW SE

SECTION PLAT<sup>1</sup>

		o	

330 Ft. from N. Line

\_\_\_\_\_ Ft. from S. Line

\_\_\_\_\_ Ft. from E. Line

330 Ft. from W. Line

Ellis County

RECORD

Location \_\_\_\_\_

Cased \_\_\_\_\_ in., \_\_\_\_\_ ft.

Rig up \_\_\_\_\_

Sand \_\_\_\_\_

Drilling and Remarks:

Gas \_\_\_\_\_

Oil \_\_\_\_\_

8" @ 210 WOC

Total Depth \_\_\_\_\_

PRODUCTION

1st 24-hrs. Nat. \_\_\_\_\_

1st 24 hrs. after shot \_\_\_\_\_

Gas \_\_\_\_\_ Cu. Ft.

Dry Hole \_\_\_\_\_

Abandoned \_\_\_\_\_

Date

OCT 8 1947

19

S. J. LEWIS

Scout