


SECTION 7 TOWNSHIP 11 S RANGE 20 W

WELL NO. # 1 Walz

COMPANY Sierra et al

NORTH SW SW NW

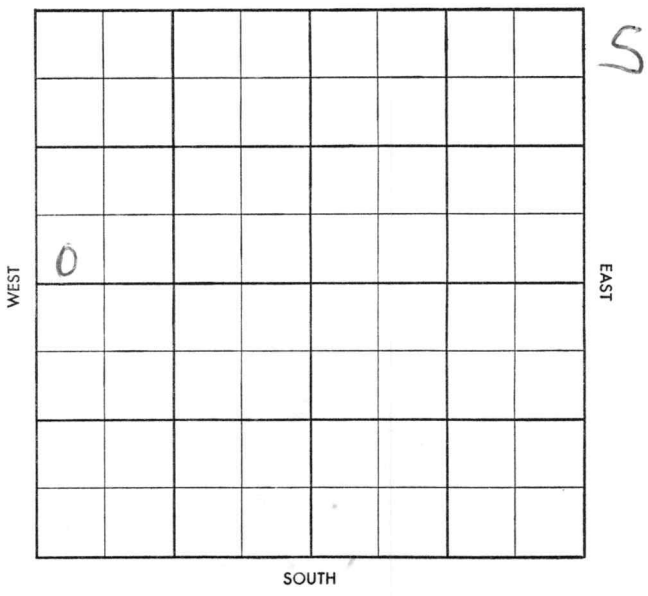



13B-0

Twp. X Pool X  
Co. X Facet X

S-513-B

County Ellis Elev. 2074 DF  
Sec. 7 Twp. 11 Rge. 20W  
Company Sierra etal  
Farm Name Walz No. 1

TOPS	DEPTH	LOG	DATUM
Anh.	1530		
Tp.	3120		
H.	3331		
Tr.	3356		
Dg.			
B.L.			
L.	3370		
K.C.			
B.K.C.	3572		
Ce.			
C.	3625		
M.			
M.			
K.			
Mz.			
Mq.			
V.			
S.			
S.			
A.	3677		
R.			
Pf.			
G.			
T.D.	3700		

Loc. in Sec. \_\_\_\_\_  
SW NW  
Geol. \_\_\_\_\_  
Contr. \_\_\_\_\_  
Co. Tools 11  
Pool Wildcat

ABANDONED  
JUL 30 '58

Date Comm. 7-19-58  
8" # 204 w/130, Drlg. 2210 Jul 30 '58 DST

3448 - 66 1h - 210 0 6 geman  
FBHP 1290 PST 3546 - 70 1h -  
60 50CM BHP 1180 DST 3674 -  
94 1h 32 VSOCM BHP 990  
no log

DOA