


Ellis

KANSAS

SECTION 7 TOWNSHIP 11 RANGE 20W

WELL NO. #1 Walz

COMPANY Kaiser-Francis

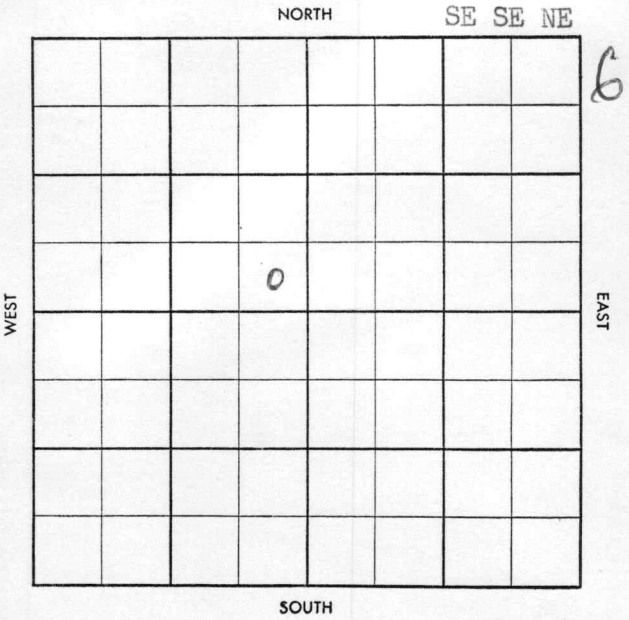

6

CO. Ellis ELEV. 2075
 SEC. 7 TWP. 11 RGE. 20W
 COMPANY Kaiser-Francis NO. 1

CO.
 ABANDONED
 OCT 16 '57

FARM Walz

LOC. SE SE NE
CSO - DHM

Ann. 1492
 TP 3108
 H6 3300
 TR 3319
 L 3337
 BKC 3571
 C 3593
 SSh 3627
 Ssd 3643
 A 3648

GEOL. _____
 CONTR. Veeder
 POOL Mendota
 SPUD 10-2-57
8" @ 226/130
drlg. 2615 OCT 16 '57
DST 3520-36
45" 60' M & W
BHP 925/20"
DST 3649-55

TD 3670 30" 8' M BHP 85
 ran log D & A

CO.
 LSE.
 NO.
 SEC.
 TWP.
 RGE.