

Section 7 Township 11 Range 21W

Well No. #1 Osborn-Monroe

Company Aurora Gasline Co.

NORTH

			0				

3

WEST

EAST

SOUTH

Trego

KANSAS

Sec. 7 Twp. 11 R. 21W

Well No. #1 Osborn-Monroe Farm

Aurora Gasoline Co. Company

Peel-Hardman - Contr. Contractor

Wildcat


330' Ft. from N. Line

..... Ft. from S. Line

330' Ft. from E. Line

..... Ft. from W. Line

NE NE NW

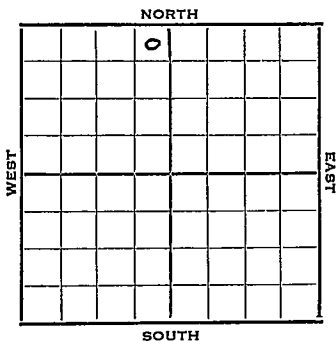

1951 Elev. 2123' REPORT

12/12 Spud 12-7-51
8" @ 150
Drlg. 2530

1952
1/2 Spud 12-7-51
D&A TD 3818
8" @ 150
Heeb. 3371 Lans. 3408
DST 3716-36 open 15 min.
Rec. 5' OCM
Arb. 3764
DST 3762-70 open 15 min.
Rec. 2' mud
DST 3772-88 open 15 min. rec. 5' mud
DST 3788-3816 open 15 min. rec. 5' mud
TD 3818'
D&A

ABANDONED

County Trego State Kansas
 Sec. 7 (Blk. 11) (Sur. 21W) (Twp.) (Rge.) Map No.
 Operator Aurora Gasoline Co.
 Well No. 1 Farm Osborn - Monroe
 Elev. 2123 Location NE NE NW

		0			

330 Ft. From N Line NW

330 Ft. From E Line Quarter

1st. Report

Completion JAN 2 1952

Remarks Wildcat

Peel - Hardman - Contr.

Spudding Date 12-7-51

Drlg. Data D & A TD 3818

8" @ 150 Heeb. 3371 Lans. 3408

DST 3716-36 open 15 min. Rec. 5' ocm

Arb. 3764 DST 3762-70 open 15 min.

Rec. 2' mud DST 3772-88 open 15 min.

Rec. 5' mud DST 3788-3816 open 15 min.

Rec. 5' mud TD 3818

D & A -

J. E. TYRA