


Map No. KANSAS Sec. 7 Twp. 11 R. 22-WWell No. 1-John Lemke Farm
McNealey et al Company

NORTH

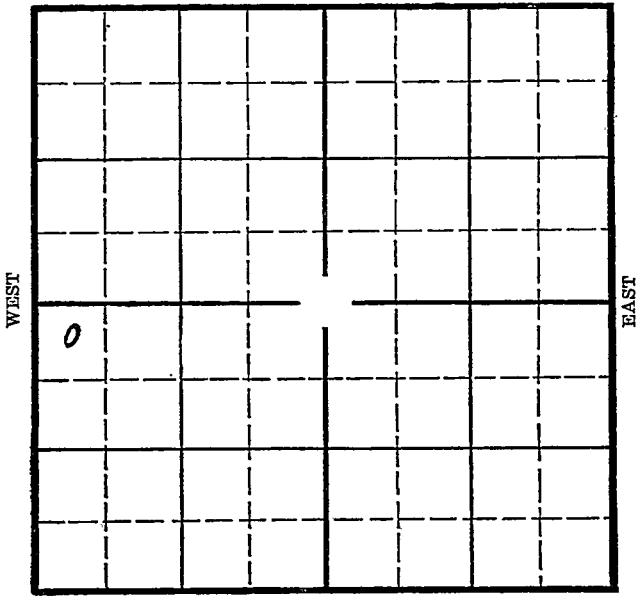

SOUTH

Location _____
Drilling Remarks _____Rig Up _____
Drilling Remarks _____

RECORD

Cased _____ in. _____ ft.

Sand _____

Gas _____

Oil _____

Total Depth _____

PRODUCTION

1st 24 hrs. Nat. _____

1st 24 hrs. after shot _____

Gas _____ cu. ft. _____

Dry Hole _____

Abandoned _____

Map No. KANSAS Sec. 7 Twp. 11 R. 22W
Well No. 1- John Lerke Farm
Mc Kenley et al Company


330 Ft. from N. Line

_____ Ft. from S. Line

_____ Ft. from E. Line

330 Ft. from W. Line

Elev. 2198

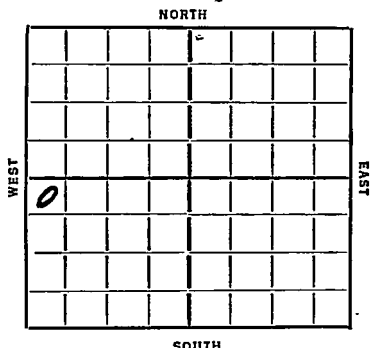

REPORT

1936
3/19 Rotary Rig
3/20 Digging cellar.
3/28 Rig.
4/2 -- 4/10-- 4/16-- 4/23-- 4/30-- 5/7--
5/14 -- 5/21-- 5/28-- 6/4-- 6/11-- 6/18--
6/25 -- 7/2-- 7/9-- 7/16--
7/23 10" @ 110'. Waiting on cement.
7/30 Drlg. 2286'
8/6 Topeka 3170'. Drlg. 3175'.
8/13 Oswald 3450'. TD 3490'.
8/20 3490' set 6". Waiting on cement.
8/27 6" @ 3487'. Hole full of water.
Drlg. 3515'.
9/3 Drlg. 3595'.
9/10 3646' streight ream 6".
9/18 Drlg. 3671'.
9/24 3671' shut down.
10/1 3671' equals 3654'. S.L.M. 5" @
3654'. Drlg. 3680'.
10/8 Moving in rotary tools.
10/18 Rigging up.
10/22 Drlg. 3816'.

OVER

10/29-Sil. ~~3900~~³⁸⁹⁰. 4040¹ shut down.

11/4-Sil. 3890 Corrected

T. D. 4040

Water D & A

ABANDONED

KANSAS

Map No. 69 Sec. 7 Twp. 11 R. 22W

Well No. 1 - John Lemke

McNealey et al Company

Contractor

FIRST REPORT

SECTION PLAT

330 Ft. from N. Line

..... Ft. from S. Line

..... Ft. from E. Line

330 Ft. from W. Line

0			

Location.....

Rig up.....

Drilling and Remarks:

RECORD

Cased.....in.,ft.

Sand.....

Gas.....

Oil.....

Total Depth.....

PRODUCTION

1st 24 hrs. Nat.....

1st 24 hrs. after shot.....

Gas.....Cu. Ft.

Dry Hole.....

Abandoned.....

Date

MAR 19 1936

ORVAL MANNSCHRECK

192

Scout

Map No. 69 Sec. 7 Twp. 11 R. 22W

Well No. John Lemke

McNealey & Co Company

Contractor

SECTION PLAT

330 Ft. from N. Line

_____ Ft. from S. Line

_____ Ft. from E. Line

330 Ft. from W. Line

ABANDONED

0			

Location _____

Rig up _____

Drilling and Remarks:

Oil 3890 connected

Water.

IT & H.

RECORD

Cased _____ in; _____ ft.

Sand _____

Gas _____

Oil _____

Total Depth 4040

PRODUCTION

1st 24 hrs. Nat. _____

1st 24 hrs. after shot _____

Gas _____ Cu. Ft.

Dry Hole _____

Abandoned _____

Date

NOV 4 1936 19

S. J. LEWIS Scout