


KANSAS

Ellis

Section 7 Township 11 Range 17-W

Well No. #2 Henderson

Company Darby Petroleum

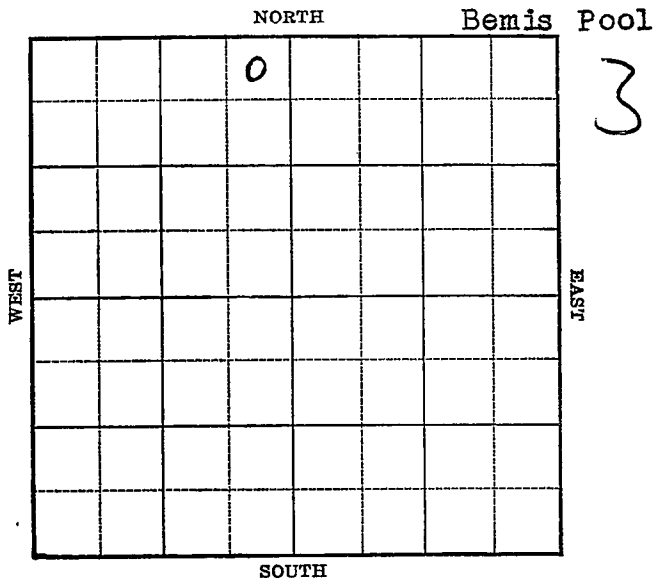

Sec. 7 Twp. 11 R. 17-W

Well No. #2 Henderson Farm

Darby Petr. Company


(Bemis)

330 Ft. from N. Line

_____ Ft. from S. Line

330 Ft. from E. Line

_____ Ft. from W. Line

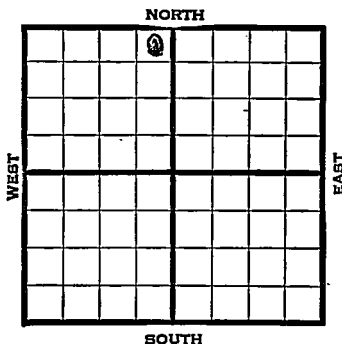

Elev. 1920

1939	REPORT
5/24	Rotary.
6/1	15" - 100' WOC.
6/8	10" @ 1180' WOC.
6/16	Anhy 1180' 10" - 1181' Drig. 1850'
6/23	Simp. Dolomite 3427' Arb. 3459' T.D. 3461' 7" - 3459' SD.
6/29	T.D. 3474' 2000 acid. No help. 3000 acid. 1100' oil in hole 4 hrs. natural
7/5	Arb. 3459' 7" - 3459' T.D. 3474' 6000 acid. Potential 2566 bbls., pump.
COMPLETED	

Map No. 71 Sec. 7 Twp. 11 R. 17WWell No. 8 HendersonDarby Petroleum

Company

Contractor

FIRST REPORT

SECTION PLAT

NE NW

330 Ft. from N. Line Ft. from S. Line330 Ft. from E. Line Ft. from W. Line

	0		

BEMIS POOL

Location _____

Rig up _____

Drilling and Remarks:

ROTARY

RECORD

Cased _____ in., _____ ft.

Sand _____

Gas _____

Oil _____

Total Depth _____

PRODUCTION

1st 24 hrs. Nat. _____

1st 24 hrs. after shot _____

Gas _____ Cu. Ft.

Dry Hole _____

Abandoned _____

Date

MAY 24 1939

S. J. LEWIS Scout

Ellis

Map No. _____ Sec. 7 Twp. 11 R. 17W

Well No. 2 Henderson

Darby Petroleum Company

Contractor

COMPLETED

NE NW

330 Ft. from N. Line

_____ Ft. from S. Line

330 Ft. from E. Line

_____ Ft. from W. Line

SECTION PLAT

		0		

BEMIS POOL

Location _____

Rig up _____

Drilling and Remarks: _____

Cor. 3459

7" @ 3459.

6000 acid

Port 2566 pump

RECORD

Cased _____ in., _____ ft.

Sand _____

Gas _____

Oil _____

Total Depth 3474

PRODUCTION

1st 24 hrs. Nat. _____

1st 24 hrs. after shot _____

Gas _____ Cu. Ft.

Dry Hole _____

Abandoned _____

Date

JUL 5 1939 19

S. J. LEWIS

Scout