


KANSAS Ellis

Section 7 Township 17 Range 17W

Well No. 1 Stein


Company Harry Gore

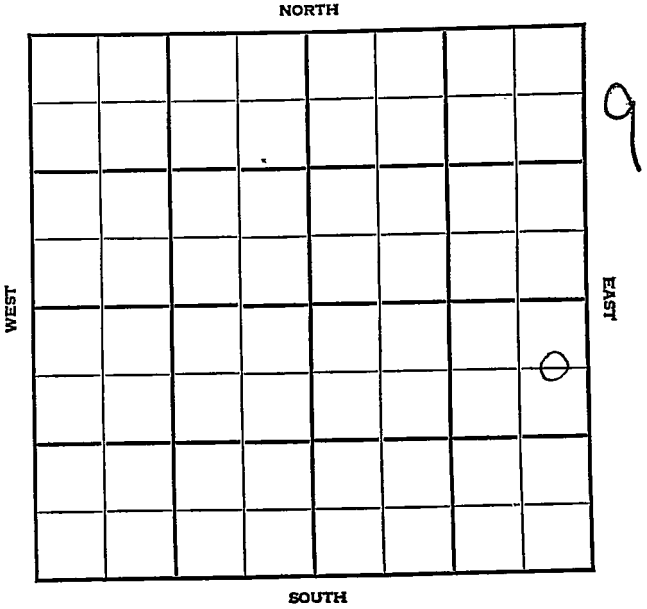

Sec. 7 Twp. 11 R. 17-W

Well No. #1 Stein Farm
Harry Gore Company
Burnett Pool

660 Ft. from N. Line
 Ft. from S. Line
330 Ft. from E. Line
 Ft. from W. Line

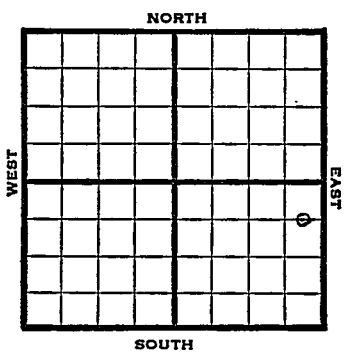

G E L N E S E

1948 ¹⁸⁵³⁶ Ele ~~2662~~ ²⁶⁶² REPORT

8/4 Location
8/11 Drlg 920'
8/18 10" @ 1095'
Drlg 2975'
8/25 Iansin 3075'
BKG 3311'
Arb. 3390'
TD 3392
5" @ 3390'
9/1 Arb 3390'
5" @ 3390'
TD 3393
Pump 25' oil Pot
36° Gr.
Comp

COMPLETED

11

Ellis County Kansas State

Map No. 71 Sec. 7 Twp. 11 R. 17W

Well No. 1 Stein

Harry Gore Company

COMPLETE

Contractor

C E L N E S E

E 11833
SECTION PLAT

660 Ft. from N. Line

 Ft. from S. Line

330 Ft. from E. Line

 Ft. from W. Line

Burnett Pool

Remarks:

CR 48890

5" 08890

DE 173393

Pump 25 oil lat.

36 = su

Date
SEP 1 1948

Scout **S. J. LEWIS**