

KANSAS

Form 51-5M-11-38-Palace


Ellis

Section 7 Township 11 Range 17-W

Well No. #2 Stein

Company Dickey Oil

NORTH Bemis Pool

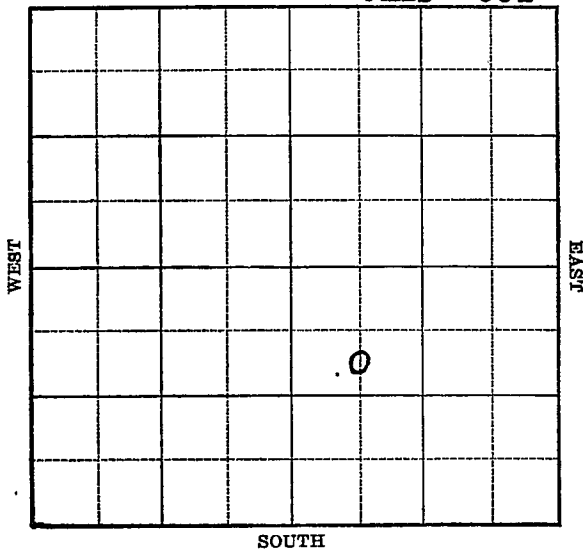

Sec. 7 Twp. 11 R. 17-W

Well No. #2 Stein Farm

Dickey Oil Company

(Bemis)


990 Ft. from N. Line

_____ Ft. from S. Line

_____ Ft. from E. Line

660 Ft. from W. Line

Elev. 1872

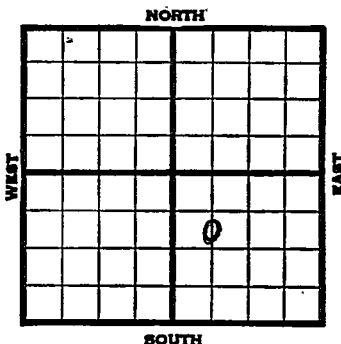

1939	REPORT
9/20	Rotary.
9/28	"
10/5	"
10/12	"
10/19	"
10/26	"
11/2	"
11/9	"
11/16	"
11/23	Drlg. 330'
11/29	Anhy 1114' 10" - 1135' Drlg. 1569'
12/7	Topeka 2942' Drlg. 3080'
12/14	Arb. 3400' 7" - 3400' T.D. 3419' RUST.
	OVER

1939
12/20

Arb. 3400'

7" - 3400'

T.D. 3419'

500 acid.

Depthograph potential 22,038 bbls

Maximum 3000 bbls.

COMPLETED

Ellis

Map No. _____ Sec. 7 Twp. 11 R. 17W

Well No. 2 Stein

Dickey Oil Company

Contractor

FIRST REPORT

SECTION PLAT

C S E NW SE

990 Ft. from N. Line

_____ Ft. from S. Line

_____ Ft. from E. Line

660 Ft. from W. Line

		o	

BEMIS POOL

Location _____

Rig up _____

Drilling and Remarks: ROTARY

RECORD

Cased _____ in., _____ ft.

Sand _____

Gas _____

Oil _____

Total Depth _____

PRODUCTION

1st 24 hrs. Nat. _____

1st 24 hrs. after shot _____

Gas _____ Cu. Ft.

Dry Hole _____

Abandoned _____

Date

SE 2 1939 19

S. J LEWIS Scout

Map No. 71 Sec. 7 Twp. 11 R. 17W

Well No. 2 Stein

Dickey Oil

Company

Contractor

COMPLETED

SECTION PLAT

C S L NW SE

990 Ft. from N. Line

_____ Ft. from S. Line

_____ Ft. from E. Line

660 Ft. from W. Line

BEMIS POOL

Location _____

Rig up _____

Drilling and Remarks:

Cor & 3400

7" @ 3400

500 quad

*Depth graph 20 &
22 @ 38.*

Maximum 3000

RECORD

Cased _____ in., _____ ft.

Sand _____

Gas _____

Oil _____

Total Depth 3419

PRODUCTION

1st 24 hrs. Nat. _____

1st 24 hrs. after shot _____

Gas _____ Cu. Ft.

Dry Hole _____

Abandoned _____

Date

DEC 20 1939 19

S. J. LEWIS Scout

small map Paul

Misc Small Maps

Cards

Tracing

France Map

Scarborough Map

Moody Map

Geological Dept.

Moody Flat Book