

KANSAS

Form 51-5M-7-39-Palace


Ellis

Section 7 Township 11 Range 17-W

Well No. #4 Henderson "A"

Company Dickey Oil

NORTH Bemis Pool

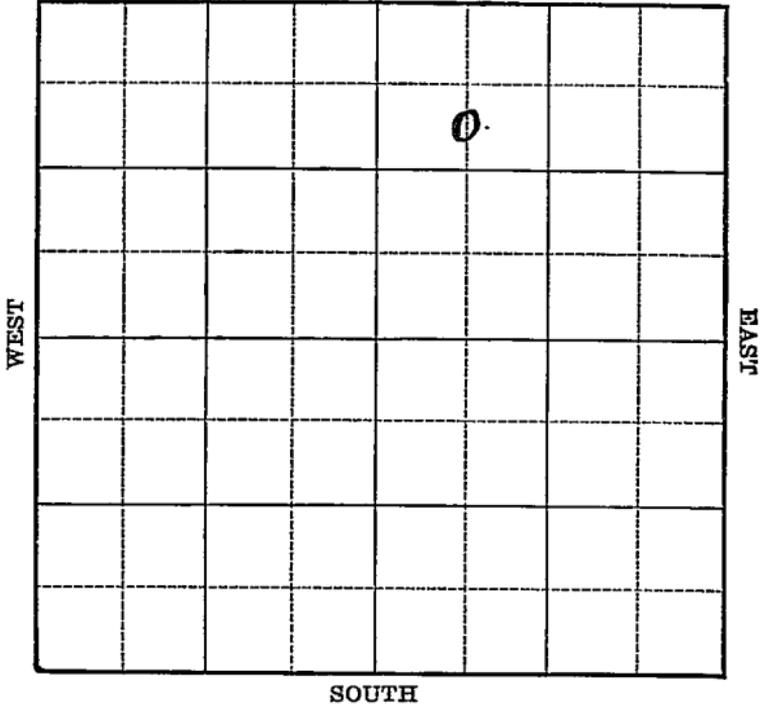

Sec. 7 Twp. 11 R. 17-W

Well No. #4 Henderson "A" Farm

Dickey Oil Company

(Bemis)


990 Ft. from N. Line

_____ Ft. from S. Line

_____ Ft. from E. Line

660 Ft. from W. Line

Elev. 1878

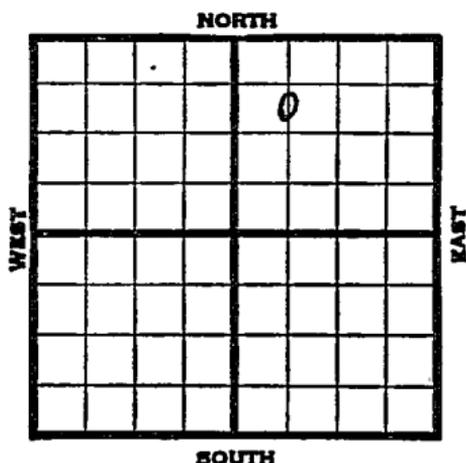

1939	REPORT
12/20	Rotary.
12/28	"
1940	
1/4	"
1/11	Anhy 1130' 10" - 1150' WOC.
1/18	Drlg. 2650'
1/25	Drlg. 3415'
2/1	Arb. 3424' 7" - 3424'
	T.D. 3428' 3000' oil 1 hour.
2/7	Arb. 3424'
	7" - 3424'
	T.D. 3428'
	Depthograph pot. 3343 bbls.
	Maximum 3000 bbls.
	COMPLETED

Map No. 71 Sec. 7 Twp. 11 R. 17WWell No. 4 Henderson "A"Dickey Oil

Company

Contractor

FIRST REPORT

C $S\frac{1}{2}$ NW NE990 Ft. from N. Line

_____ Ft. from S. Line

_____ Ft. from E. Line

660 Ft. from W. Line

SECTION PLAT

		o	

BEMIS POOL

Location _____

Rig up _____

Drilling and Remarks:

. Rotary

RECORD

Cased _____ in., _____ ft.

Sand _____

Gas _____

Oil _____

Total Depth _____

PRODUCTION

1st 24 hrs. Nat. _____

1st 24 hrs. after shot _____

Gas _____ Cu. Ft.

Dry Hole _____

Abandoned _____

Date

DEC 20 1939 19

S. J. LEWIS Scout

Map No. 71 Sec. 7 Twp. 11 R. 17WWell No. 4 Henderson "A"Dickey Oil Company

Contractor

COMPLETED

C $S\frac{1}{2}$ NW NE990 Ft. from N. Line

_____ Ft. from S. Line

_____ Ft. from E. Line

660 Ft. from W. Line

BEMIS POOL

SECTION PLAT

		o	

Location _____

Rig up _____

Drilling and Remarks:

*Cut 3424**- 7" @ 3424**Depthograph Plot.**3343**Maximum 3000*

RECORD

Cased _____ in., _____ ft.

Sand _____

Gas _____

Oil _____

Total Depth 3428

PRODUCTION

1st 24 hrs. Nat. _____

1st 24 hrs. after shot _____

Gas _____ Cu. Ft.

Dry Hole _____

Abandoned _____

Date

FEB 7 1940₁₉S. J. LEWIS Scout