

KANSAS

Form 51—5M—7-39—Palace

Ellis

Section 7 Township 11 Range 17-W

Well No. #7 Henderson

Company Darby Petroleum


Burnett Pool

NORTH

WEST

EAST

SOUTH

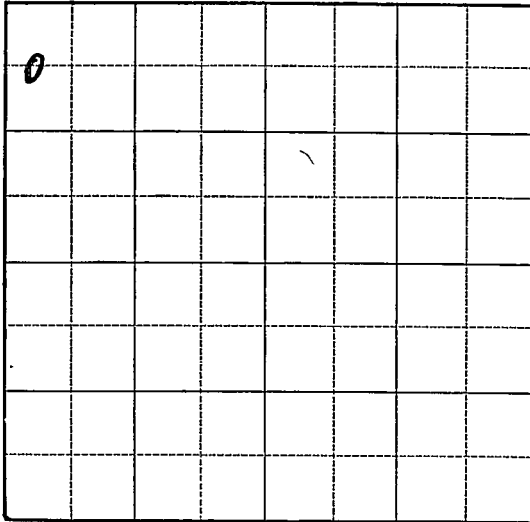

Sec. 7 Twp. 11 R. 17-W

Well No. #7 Henderson Farm

Darby Petr. Company

(Burnett)


660 Ft. from N. Line

Ft. from S. Line

Ft. from E. Line

330 Ft. from W. Line

Elev. 1925

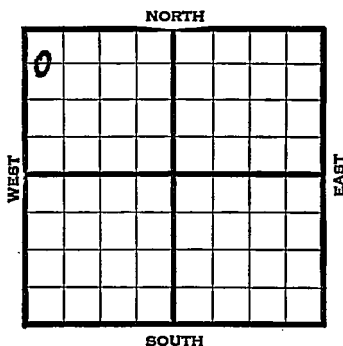[illegible]

Map No. 7/ Sec. 7 Twp. 11 R. 17WWell No. 7 HendersonDarby Petroleum Company

Contractor

FIRST REPORT

C $W\frac{1}{2}$ NW NW

SECTION PLAT

0			

660 Ft. from N. Line

Ft. from S. Line

Ft. from E. Line

330 Ft. from W. Line

BURNETT POOL

Location

Rig up

Drilling and Remarks:

Rigging up Roty.

RECORD

Cased _____ in., _____ ft.

Sand _____

Gas _____

Oil _____

Total Depth _____

PRODUCTION

1st 24 hrs. Nat. _____

1st 24 hrs. after shot _____

Gas _____ Cu. Ft.

Dry Hole _____

Abandoned _____

Date

MAY 8 1940
19

S. J. LEWIS

Scout

Map No. 71 Sec. 7 Twp. 11 R. 17WWell No. 7 HendersonDarby Petroleum Company

Contractor

COMPLETED

C $W\frac{1}{2}$ NW NW660 Ft. from N. Line

Ft. from S. Line

Ft. from E. Line

330 Ft. from W. Line

SECTION PLAT

0			

BURNETT POOL

Location

Rig up

Drilling and Remarks:

*Cor 8 3441 1/2**7" @ 3441 1/2**500 acio**Dynograph 8 8**46 1/8**Maximum 3000*

RECORD

Cased _____ in., _____ ft.

Sand _____

Gas _____

Oil _____

Total Depth 3447

PRODUCTION

1st 24 hrs. Nat. _____

1st 24 hrs. after shot _____

Gas _____ Cu. Ft.

Dry Hole _____

Abandoned _____

Date

JUN 5 1940 19

S. J. LEWIS Scout