

KANSAS

Ellis


Form 51-5M-7-39-Palace

Section 7 Township 11 Range 17-W

Well No. #6 Henderson

Company Darby

NORTH Burnett Pool

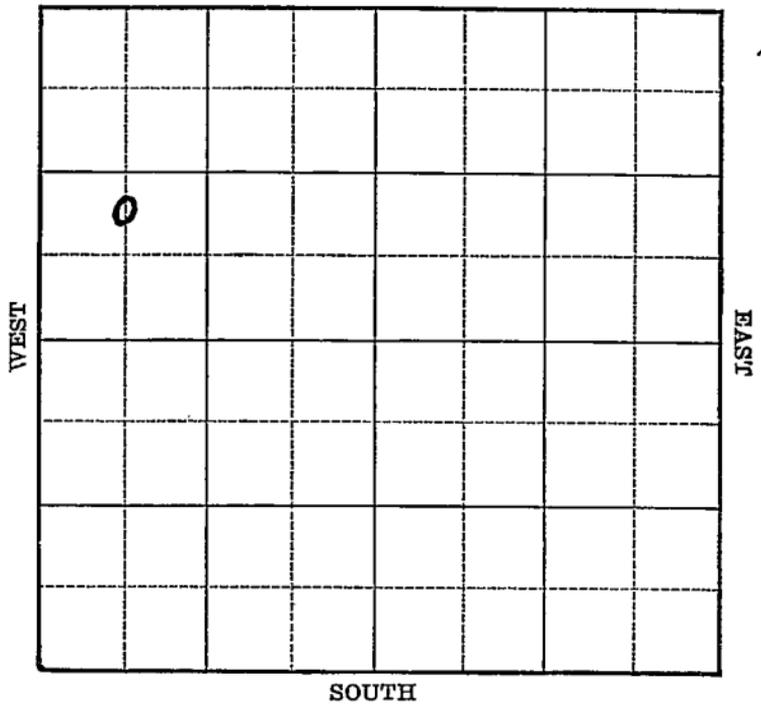

Sec. 7 Twp. 11 R. 17-W

Well No. #6 Henderson Farm

Darby Petr. Company

(Burnett)


~~990~~ Ft. from N. Line

990 Ft. from S. Line

_____ Ft. from E. Line

660 Ft. from W. Line

Elev. 1882

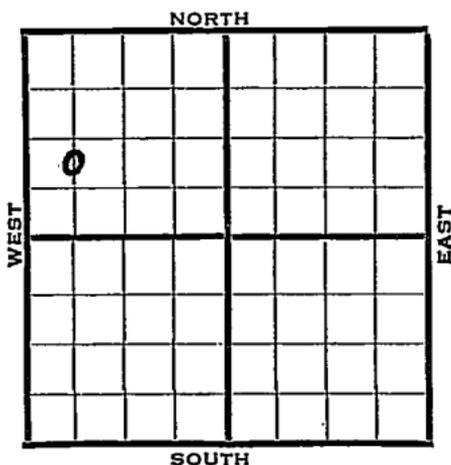

1940	REPORT
<u>4/17</u>	Rotary.
<u>4/25</u>	15" - 115' Anhy 1125'
	10" - 1128' WOC.
<u>5/2</u>	Drlg. 2800'
<u>5/9</u>	Arb. 3397-66' ^{3397'} T.D. 7" - 3387' ^{3385'}
	RUST.
<u>5/15</u>	Arb. 3391' (Corrected)
	7" - 3385'
	T.D. 3397'
	500 acid.
	Depthograph potential 14728 bbls.
	Maximum 3000 bbls.

COMPLETED

Map No. 71 Sec. 7 Twp. 11 R. 17WWell No. 6 HendersonDarby CompanyCORRECTION Contractor

SECTION PLAT

C N L SW NW

 Ft. from N. Line990 Ft. from S. Line Ft. from E. Line660 Ft. from W. Line

BURNETT POOL

o			

Location Rig up

Drilling and Remarks:

Reported 990'
from N. Line

RECORD

Cased in., ft.Sand Gas Oil Total Depth

PRODUCTION

1st 24 hrs. Nat. 1st 24 hrs. after shot Gas Cu. Ft.Dry Hole Abandoned

Date

APR 20 1940₁₉S. J. LEWIS Scout

Map No. _____ Sec. 7 Twp. 11 R. 17WWell No. 6 Henderson
Darby Petroleum Company

Contractor _____

FIRST REPORT

SECTION PLAT

C N L SW NW

o			

990 Ft. from N. Line

_____ Ft. from S. Line

_____ Ft. from E. Line

660 Ft. from W. Line

BURNETT POOL

Location _____

Rig up _____

Drilling and Remarks:

Rotary

RECORD

Cased _____ in., _____ ft.

Sand _____

Gas _____

Oil _____

Total Depth _____

PRODUCTION

1st 24 hrs. Nat. _____

1st 24 hrs. after shot _____

Gas _____ Cu. Ft.

Dry Hole _____

Abandoned _____

Date

APR 17 1940 19

S. J. LEWIS Scout

Map No. 71 Sec. 7 Twp. 11 R. 17W

Well No. 6 Henderson

Darby Company

Contractor

COMPLETED

C N L SW NW

_____ Ft. from N. Line

990 Ft. from S. Line

_____ Ft. from E. Line

660 Ft. from W. Line

BURNETT POOL

SECTION PLAT

e			

Location _____

Rig up _____

Drilling and Remarks:

Core 3391 @ 3397
7" @ 3385
500 acid
Depthograph R & Y
14728
Map 3000

RECORD

Cased _____ in., _____ ft.

Sand _____

Gas _____

Oil _____

Total Depth 3397

PRODUCTION

1st 24 hrs. Nat. _____

1st 24 hrs. after shot _____

Gas _____ Cu. Ft.

Dry Hole _____

Abandoned _____

Date

MAY 15 1940

19

S. J. LEWIS Scout