

KANSAS

Ellis


Form 51-5M-7-40-Palace

Section 7 Township 11 Range 17-W

Well No. #6 Stein

Company Dickey Oil

NORTH Bemis Pool

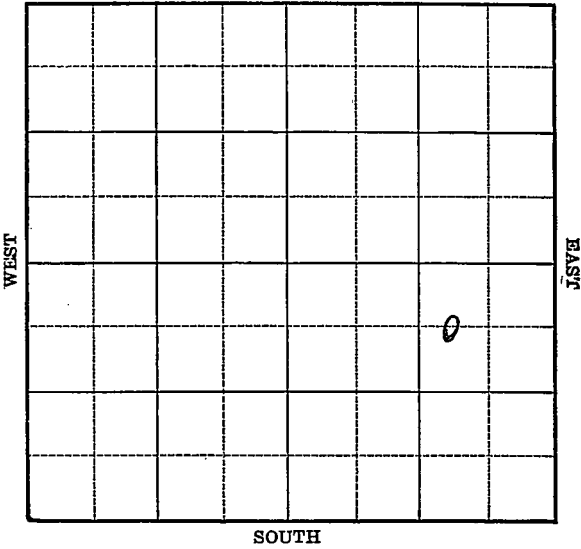

Map No. 71 Sec. 7 Twp. 11 R. 17W

Well No. 6 Stein

Dickey Oil Company

Contractor

COMPLETED

C W L N E S E

660 Ft. from N. Line

_____ Ft. from S. Line

990 Ft. from E. Line

_____ Ft. from W. Line

Bemis Pool

SECTION PLAT

			o

Location: _____

Rig up _____

Drilling and Remarks:

1000 acid

*Explosives
potential*

7447 bbls

33.5 gravity

RECORD

Cased _____ in. _____ ft.

Sand *Artuckle 3401*

Gas _____

Oil _____

Total Depth *3408*

PRODUCTION

1st 24 hrs. Nat. _____

1st 24 hrs. after shot _____

Gas _____ Cu. Ft.

Dry Hole _____

Abandoned _____

Date

APR 16 1941 19

S. J. LEWIS

Scout