


Section 7 Township 11 Range 17-W

Well No. #6 Jorgenson

Company Darby Petroleum

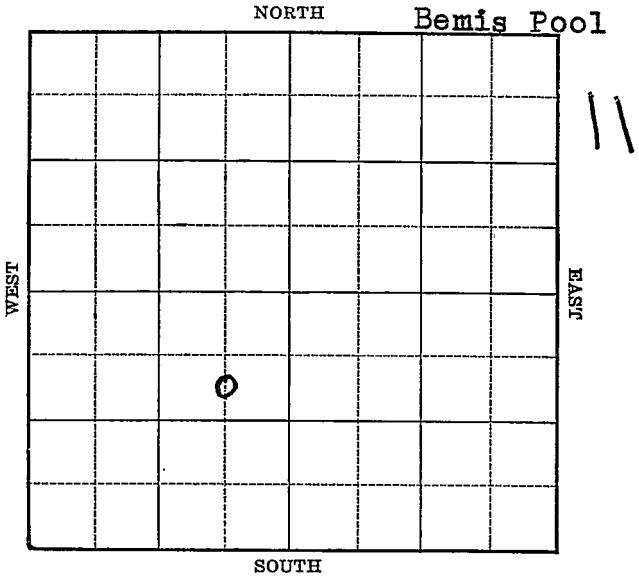

Sec. 7 Twp. 11 R. 17-W

Well No. #6 Jorgenson Farm

Darby Petr. Company


(Bemis)

990 Ft. from N. Line

_____ Ft. from S. Line

660 Ft. from E. Line

_____ Ft. from W. Line

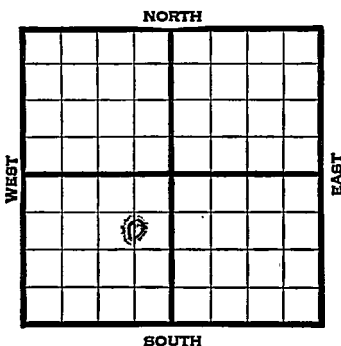

| 1939 | REPORT |
|-------|---|
| 8/9 | Rotary. |
| 8/17 | " |
| 8/24 | " |
| 8/31 | " |
| 9/7 | " |
| 9/14 | " |
| 9/21 | 106' run 15". |
| 9/28 | 15" - 106' Anhy 1103' |
| | 10" - 1107' WOG. |
| 10/5 | Arb. 3377' ^{3377'} 7" - 3380' ^{3377'} RUST. |
| 10/12 | Arb. 3377' (Corrected) |
| | 7" - 3377' T.D. 3384' |
| | 3000' oil. |
| 10/18 | Arb. 3377' |
| | 7" - 3377' |
| | T.D. 3384' |
| | Potential 3500 bbls. |
| | COMPLETED |

Map No. 77 Sec. 7 Twp. 11 R. 17W

Well No. 6 Jorgenson

Darby Petroleum Company

Contractor

FIRST REPORT

SECTION PLAT

C S $\frac{1}{2}$ NE SW

990 Ft. from N. Line

_____ Ft. from S. Line

660 Ft. from E. Line

_____ Ft. from W. Line

| | | | |
|--|--|--|--|
| | | | |
| | | | |
| | | | |
| | | | |

BEMIS POOL

Location _____

RECORD

Rig up _____

Cased _____ in., _____ ft.

Drilling and Remarks:

Sand _____

Rotary

Gas _____

Oil _____

Total Depth _____

PRODUCTION

1st 24 hrs. Nat. _____

1st 24 hrs. after shot _____

Gas _____ Cu. Ft.

Dry Hole _____

Abandoned _____

Date

AUG 9 1939 19

S. J. LEWIS Scout

Map No. 7/ Sec. 7 Twp. 11 R. 17W

Well No. 6 Jorgenson

Darby Petroleum

Company

Contractor

COMPLETED

C S $\frac{1}{2}$ NE SW

990 Ft. from N. Line

_____ Ft. from S. Line

660 Ft. from E. Line

_____ Ft. from W. Line

SECTION PLAT

| | | | |
|--|--|--|--|
| | | | |
| | | | |
| | | | |
| | | | |

BEMIS POOL

Location _____

Rig up _____

Drilling and Remarks:

2 8 3377

7" @ 3377

P 2 8 3500

RECORD

Cased _____ in., _____ ft.

Sand _____

Gas _____

Oil _____

Total Depth 3384

PRODUCTION

1st 24 hrs. Nat. _____

1st 24 hrs. after shot _____

Gas _____ Cu. Ft.

Dry Hole _____

Abandoned _____

Date

OCT 18 1939 19

S. J LEWIS

Scout