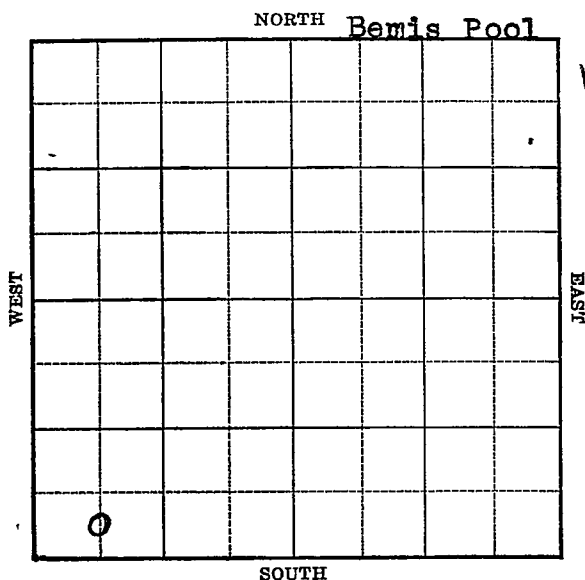


Section 7 Township 11 Range 17-WWell No. #4 JorgensonCompany Darby

KANSAS

E77 is

Sec. 7 Twp. 11 R. 17-W

Well No. #4 Jorgenson Farm

Darby Company

(Bemis)


Ft. from N. Line

330 Ft. from S. Line

Ft. from E. Line

660 Ft. from W. Line

Elev. 1852

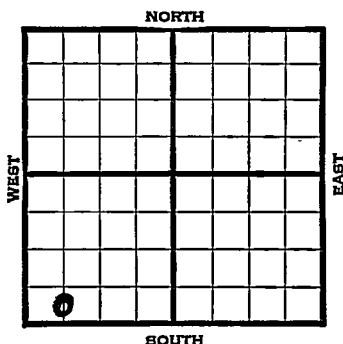[illegible]

Ellis

KANSAS

Map No. _____ Sec. 7 Twp. 11 R. 17WWell No. 4 JorgensonDarby

Company _____

Contractor _____

FIRST REPORT

C S $\frac{1}{2}$ SW SW

_____ Ft. from N. Line

330 Ft. from S. Line

_____ Ft. from E. Line

660 Ft. from W. Line

BEMIS POOL

SECTION PLAT

Location X

Rig up _____

Drilling and Remarks: _____

RECORD

Cased _____ in., _____ ft.

Sand _____

Gas _____

Oil _____

Total Depth _____

PRODUCTION

1st 24 hrs. Nat. _____

1st 24 hrs. after shot _____

Gas _____ Cu. Ft.

Dry Hole _____

Abandoned _____

Date

JUN 21 1939 19C. J. LEWIS

Scout

Map No. 71 Sec. 7 Twp. 11 R. 17WWell No. 4 JorgensonDarby

Company

Contractor

COMPLETED

C S $\frac{1}{2}$ SW SW Ft. from N. Line330 Ft. from S. Line Ft. from E. Line660 Ft. from W. Line

SECTION PLAT

0			

BEMIS POOL

Location Rig up Drilling and Remarks: *Cor & 3326**7" @ 3327**500 acid**P & 3500 Maximum*

RECORD

Cased in., ft.Sand Gas Oil Total Depth 3336

PRODUCTION

1st 24 hrs. Nat. 1st 24 hrs. after shot Gas Cu. Ft.Dry Hole Abandoned

Date

JUL 26 1939

19

S. J. LEWIS

Scout