


Section 7 Township 11 Range 17-W

Well No. #5 Jorgenson

Company Darby Petroleum

NORTH Bemis Pool

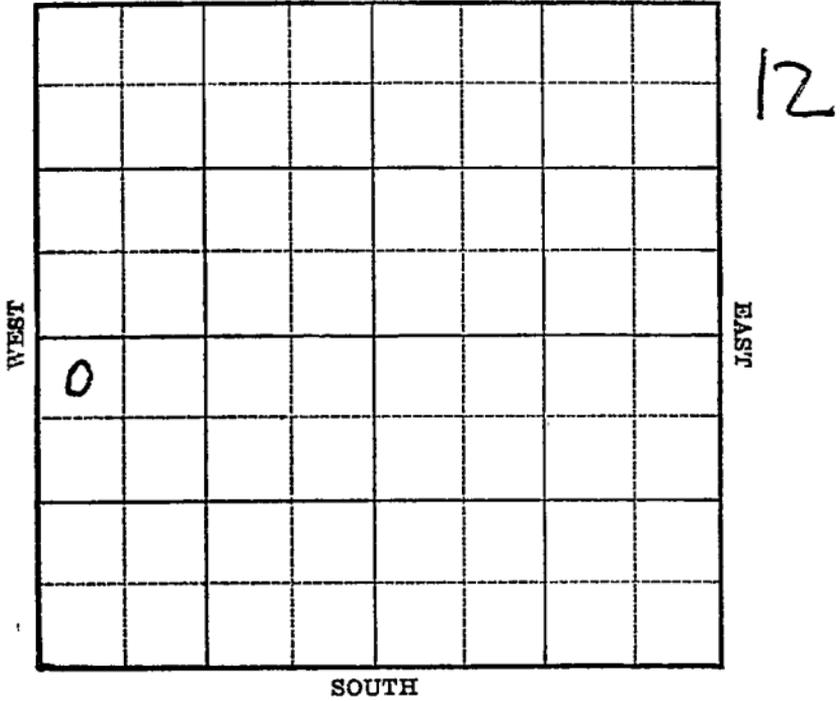

Sec. 7 Twp. 11 R. 17-W

Well No. #5 Jorgenson Farm
Darby Petr. Company

(Bemis)


330 Ft. from N. Line

_____ Ft. from S. Line

_____ Ft. from E. Line

330 Ft. from W. Line

Elev. 1866

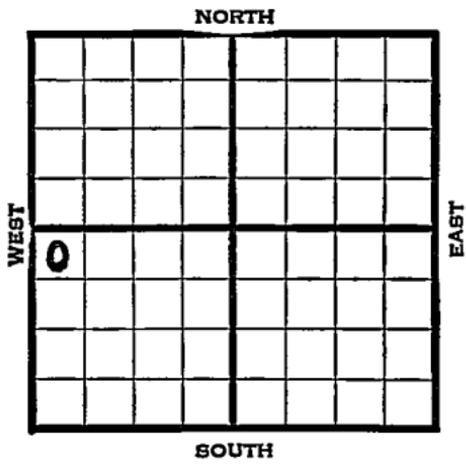

1939	REPORT
7/12	Rotary.
7/20	15" - 105' Anhy 1090'
	10" - 1103' WOC.
7/27	Drilg. 2818'
8/3	Cong. 3325' Simp. Dolo. 3333'
	Arb. 3348' 7" - 3348'
	T.D. 3354' 2800' oil 3 hrs.
	500 acid. No test.
8/9	Arb. 3348'
	7" - 3348'
	T.D. 3354'
	500 acid.
	Depthograph potential 26,135 bbl
	Maximum 3500 bbls.
	COMPLETED

Map No. _____ Sec. 7 Twp. 11 R. 17W

Well No. 5 Jorgenson

Darby Petroleum

Company

Contractor

PT 7

SECTION PLAT

NW SW

330 Ft. from N. Line

_____ Ft. from S. Line

_____ Ft. from E. Line

330 Ft. from W. Line

o.			

BEMIS POOL

Location _____

Rig up _____

Drilling and Remarks:

Rotary

RECORD

Cased _____ in., _____ ft.

Sand _____

Gas _____

Oil _____

Total Depth _____

PRODUCTION

1st 24 hrs. Nat. _____

1st 24 hrs. after shot _____

Gas _____ Cu. Ft.

Dry Hole _____

Abandoned _____

Date

JUL 12 1939

19

S. J. LEWIS

Scout

Misc Small Maps
Cards
Tracing
France Map
Scarborough Map
Moody Map
Geological Dept.
Moody Flat Book

RAM
RAM
RAM

Map No. _____ Sec. 7 Twp. 11 R. 17W

Well No. 5 Jorgenson

Darby Petroleum Company

Contractor

COMPLETED

NW SW

330 Ft. from N. Line

_____ Ft. from S. Line

_____ Ft. from E. Line

330 Ft. from W. Line

BEMIS POOL

SECTION PLAT

o			

Location _____

Rig up _____

Drilling and Remarks:

Core 3348
7" @ 3348
500 acid
Depthograph 28
26, 135
Maximum
3500

RECORD

Cased _____ in., _____ ft.

Sand _____

Gas _____

Oil _____

Total Depth 3354

PRODUCTION

1st 24 hrs. Nat. _____

1st 24 hrs. after shot _____

Gas _____ Cu. Ft.

Dry Hole _____

Abandoned _____

Date

AUG 9 1939

19

S. J. LEWIS

Scout

Misc. Small Maps	<i>Handwritten mark</i>
Cards	<i>Handwritten mark</i>
Tracing	<i>Handwritten mark</i>
France Map	<i>Handwritten mark</i>
Scarborough Map	<i>Handwritten mark</i>
Moody Map	<i>Handwritten mark</i>
Geological Dept.	
Moody Flat Book	