



Sec. 7 Twp. 11 R. 17-W

Well No. #8 Jorgenson Farm

Darby Petr. Company

(Bemis)


\_\_\_\_\_ Ft. from N. Line

330 Ft. from S. Line

660 Ft. from E. Line

\_\_\_\_\_ Ft. from W. Line

Elev. 1850

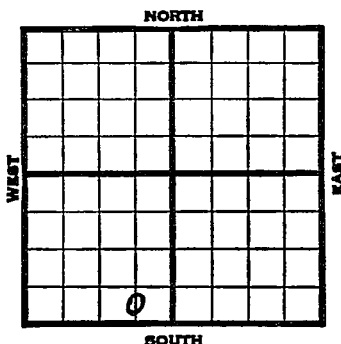

1940	REPORT
2/28	Derrick.
3/8	15" - 103' Anhy 1081'
	10" - 1083' Drlg. 1086'
3/14	Drlg. 3128'
3/21	Arb. 3349' 7" - 3350'
	T.D. 3356' 2950' oil 4 hours.
	500 acid. On potential.
3/27	Arb. 3349'
	7" - 3350'
	T.D. 3356'
	500 acid.
	Depthograph potential 30,200
	Maximum 3000 bbls.
	<b>COMPLETED</b>

Map No. 71 Sec. 7 Twp. 11 R. 17WWell No. 8 JorgensonDarby Petroleum

Company.

Contractor

FIRST REPORT  
C S L SE SW

## SECTION PLAT


         Ft. from N. Line330 Ft. from S. Line660 Ft. from E. Line         Ft. from W. Line

BEMIS POOL

Location         Rig up         

Drilling and Remarks:

Derrick

## RECORD

Cased          in.,          ft.Sand         Gas         Oil         Total Depth         

## PRODUCTION

1st 24 hrs. Nat.         1st 24 hrs. after shot         Gas          Cu. Ft.Dry Hole         Abandoned         

Date

FEB 29 1940

19

S. J. LEWIS

Scout

Misc Small Maps  
Cards  
Tracing  
France Map  
Scarborough Map  
Moody Map  
Geological Dept.  
Moody Flat Book

*DMJ*  
*DMJ*  
*DMJ*  
*DMJ*



Misc. Small Maps	<i>Ray</i>
Cards	<i>Ray</i>
Tracing	<i>Ray</i>
France Map	<i>Ray</i>
Scarborough Map	<i>Ray</i>
Moody Map	<i>Ray</i>
Geological Dept.	
Moody Plat Book	