

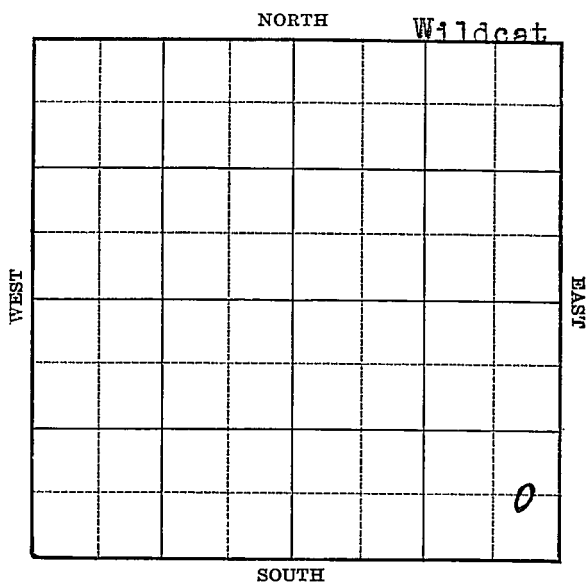
Form 51-5M-7-39-Palace

Ellis

Section 8 Township 11 Range 16-W

Well No. #1 Craig

Company Virginia Drilling et al



Sec. 8 Twp. 11 R. 16-W

Well No. #1 Craig Farm

Virginia Drilling et al Company

(Wildcat)

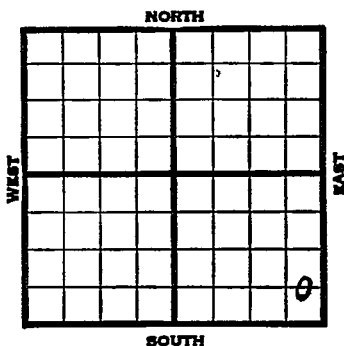
Ft. from N. Line

660 Ft. from S. Line

330 Ft. from E. Line

Ft. from W. Line

Elev. 1850

[illegible]

Ellis

KANSAS

Map No. 71 Sec. 8 Twp. 11 R. 16WWell No. 1 CraigVirginia Drilling etal Company

Contractor

FIRST REPORT
C E L S E S E

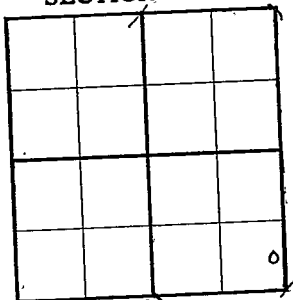
Ft. from N. Line

660 Ft. from S. Line330 Ft. from E. Line

Ft. from W. Line

WILDCAT

SECTION PLAT

Location X

Rig up

Drilling and Remarks:

RECORD

Cased _____ in., _____ ft.

Sand _____

Gas _____

Oil _____

Total Depth _____

PRODUCTION

1st 24 hrs. Nat. _____

1st 24 hrs. after shot _____

Gas _____ Cu. Ft.

Dry Hole _____

Abandoned _____

Date

OCT 18 1939 19

S. J. LEWIS Scout

Ellis

KANSAS

Map No. 71 Sec. 8 Twp. 11 R. 16WWell No. 1 CraigVirginia Drilling etal Company

Contractor

ABANDONED
C E L S E S E Ft. from N. Line660 Ft. from S. Line330 Ft. from E. Line Ft. from W. Line

WILDCAT

SECTION PLAT

			0

Location Rig up

Drilling and Remarks:

*Cr 8.3454**No shows*

RECORD

Cased in., ft.Sand Gas Oil Total Depth 3490

PRODUCTION

1st 24 hrs. Nat. 1st 24 hrs. after shot Gas Cu. Ft.Dry Hole Abandoned

Date

DEC 13 1939 19

S J LEWIS Scout