
DX 78-1 Ellis

KANSAS

Section 8 Township 11 Range 16W

Well No. #1 Lieb

Company Frontier Oil

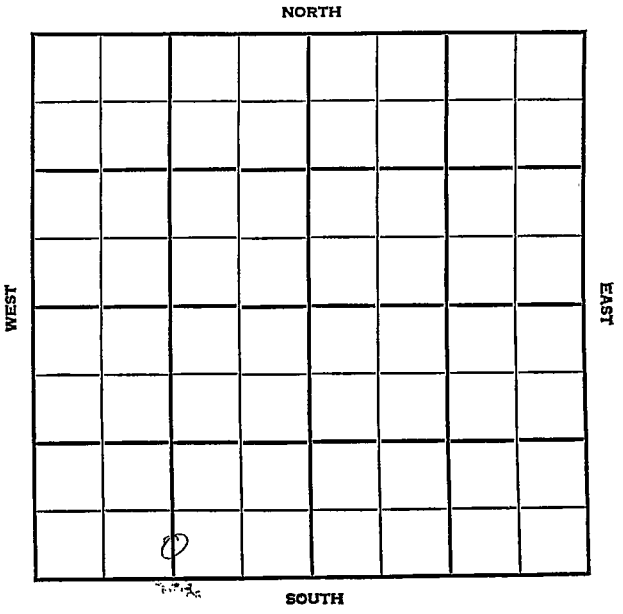

Ellis KANSAS

SEC.	TWP.	R.
8 -	11	16W

WELL NO. #1 Lieb FARM

COMPANY Frontier Oil

CONTRACTOR Strata

Lieb


_____ FT. FROM N. LINE

_____ FT. FROM S. LINE

_____ FT. FROM E. LINE

_____ FT. FROM W. LINE

C S½ S½ SW

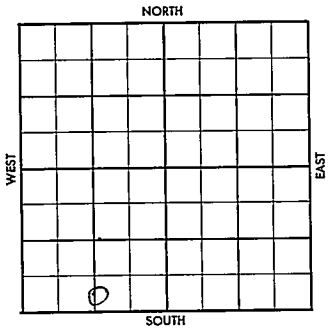

1956	ELEVATION REPORT
8-22	Comm. 8-15-56 8" @ 1017 w/450 Drlg. 2780

FORM 504-5 SUNRAY

FORM 513 SUNRAY

County Ellis Elev.

Sec. 8 Twp. 11 Rge. 16W

Company Frontier Oil

FarmName Lieb No. 1

TOPS	DEPTH	LOG	DATUM
Anh.	1007		
Tp.			
H.			
Tr.			
Dg.			
Bl.			
L.			
K.C.			
B.K.C.			
Ce.			
C.			
M.			
M.			
K.			
Mz.			
Mo.			
V.			
S.			
S.			
A			
R.			
Pe.			
G.			
TD			

Loc. in Sec. C S½ S½ SW

Geol.

Contr. Strata

Pool Lieb

FIRST REPORT

AUG 22 '56

Ø

Co. Lse. No. Sec. T. R.

Date Comm. 8-15-56

8" @ 1017/450 drlg. 2780

68W & S 80A

S. R.

FORM 513 SUNRAY

County Ellis Elev. 1809 1821 E

Sec. 8 Twp. 11 Rge. 16W

Company Frontier Oil

Farm Name Lieb No. 1

TOPS	DEPTH	LOG	DATUM
Anh.	1007		
Tp.			
H.	2961		
Tr.	2984		
Dg.			
Bl.			
L.	3005		
K.C.			
B.K.C.	3248		
Ce.			
C.	3290		
M.			
M.			
K.			
Mz.			
Mc.			
V.			
S.	3318		
S.			
A	3370		-1558
R.			
Pe.			
G.			
T.D.	3375		

Loc. in Sec. C S½ S½ SW

Geol.

Contr. Strata

Pool Lieb

COMPLETE
SEP 26 '56

Date Comm. 8-15-56

8⅝" @ 1017/450 drlg. 2780 AUG 29 '56

DST 3038-70 2 hrs 150' HGC
ESOCM BHP 900/20" DST 3371
-75 OR 2 hrs rec 2530' OIL
BHP 1020/30 4½ @ 3372/150
CO SEP 5 '56 CO 3375 & 22 Boph SEP 19 '56
nolw 4 hrs POP SEP 12 '56
SEP 26 '56 PhP 83 Bopd no/w