


Section 8 Township 11 Range 15-W

Well No. #1 Maier

Company Tom Allen

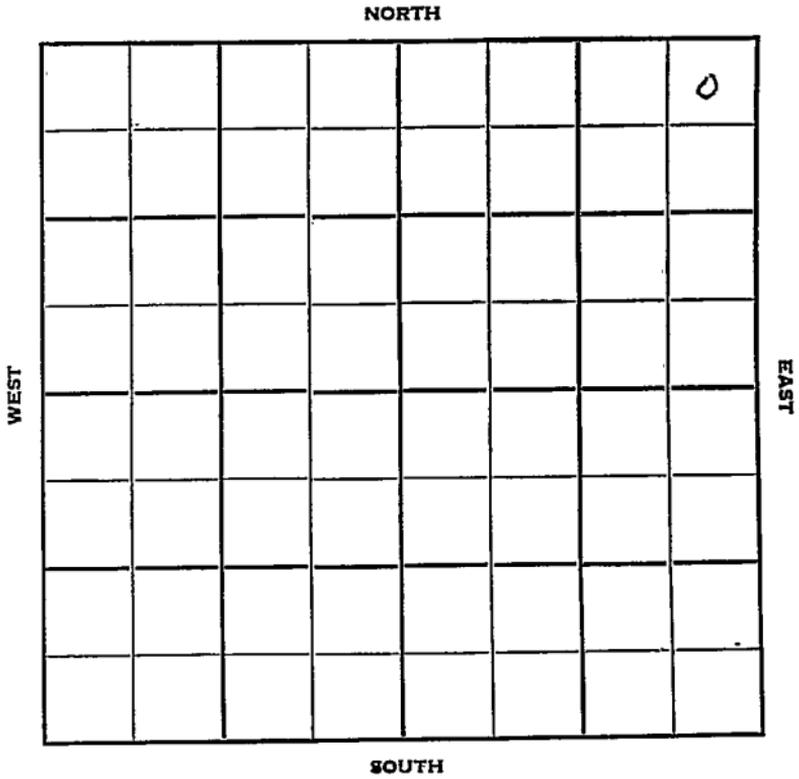

Sec. 8 Twp. 11 R. 4

Well No. #1 Maier Farm

Tom Allen Company

Allen Contractor

Fairport


330 Ft. from N. Line

_____ Ft. from S. Line

330 Ft. from E. Line

_____ Ft. from W. Line

NE NE NE

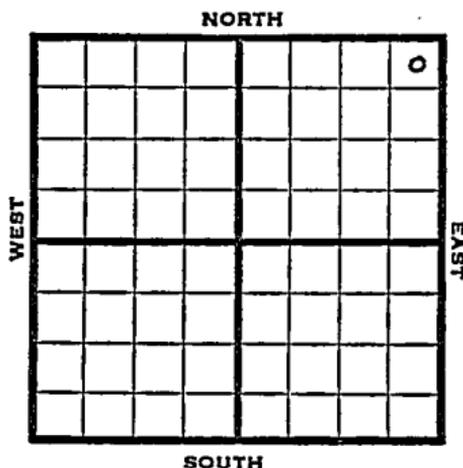

1950 Elev 1937 REPORT

11/8 Spud 11-1-50
8 5/8" @ 97
Drlg 2264

11/22 Spud 11-1-50
D&A TD 3459'
8-5/8" @ 97'
Anhy 1050' Heeb 3035'
Dodge 3059' Lans. 3086'
SO 3117-19
DST 3115-26 opn 1 hr
Rec 150' mud & sw
DST 3296-3313 opn 45 min
Rec. 20' mud Arb 3422'
DST 3425-35 opn 1 hr
Rec. 15' mud TD 3459'
D&A

ABANDONED

