


Map No. **KANSAS** Sec. *8* Twp. *11* R. *15W*
Well No. *1* *Maize* Farm
Liggett *Wal* Company

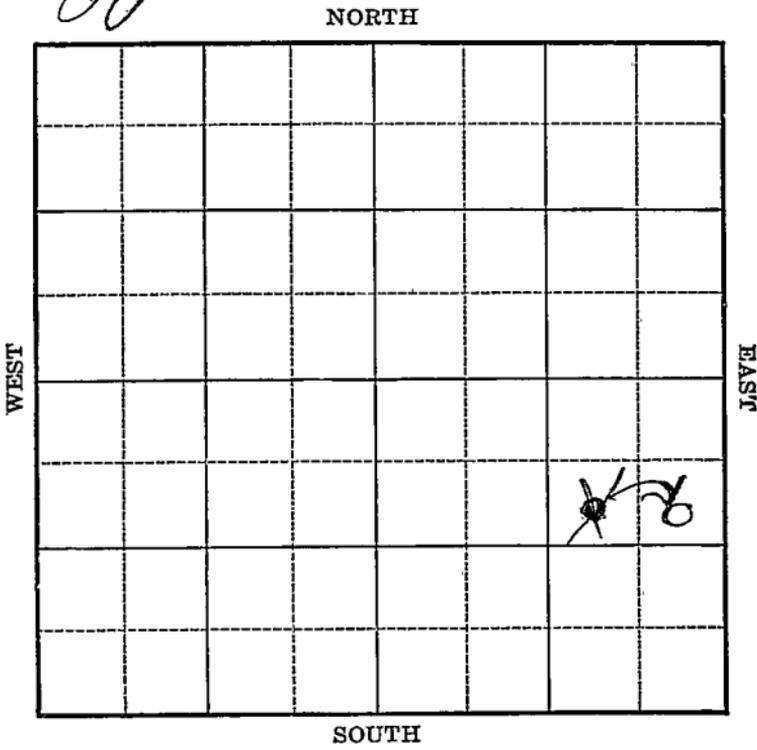

Location _____

Rig Up _____

Drilling Remarks _____

Drilling Remarks _____

RECORD

PRODUCTION

Cased _____ in. _____ ft.

1st 24 hrs. Nat. _____

Sand _____

1st 24 hrs. after shot _____

Gas _____

Gas _____ cu. ft.

Oil _____

Dry Hole _____

Total Depth _____

Abandoned _____

Map No. **KANSAS** Sec. 8 Twp. 11 R. 15w


Well No. 1-Mairr Farm
Liggett et al. Company

990 Ft. from N. Line

..... Ft. from S. Line

330
~~990~~ Ft. from E. Line

..... Ft. from W. Line

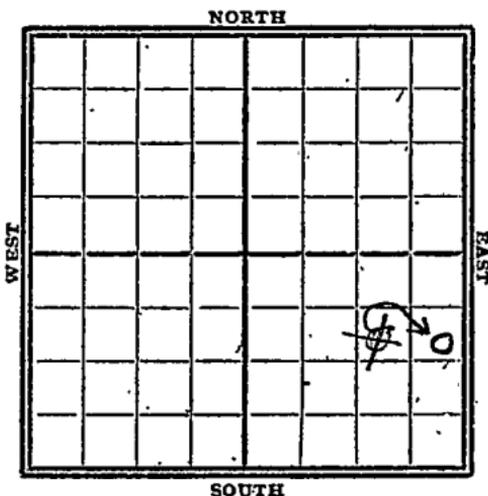

1928

Date	REPORT
7/25	R.O.G.
8/1	Blag rig
8/7	Spud
8/15	~
8/22	Drly 300'
9/5	" 875'
9/12	" 1783'
9/19	" 2210'
9/26	" 2580'
10/3	Top Oswald 3016'
10/10	Drly 3120'
10/17	" 3165'
10/24	" 3196'
10/31	show oil 3209-12'
	Drly 3280'
"/7	5" at 3363' Drly 3335'
11/14	Gorham sd 3358'
	HFW 3400
	TD 3433
	Dry & Abandoned

Map No. KANSAS Sec. 8 Twp. 11 R. 15W

Well No. 1 Mair

Liggitt & Co. Company

Contractor

SECTION PLAT

990 Ft. from N. Line

----- Ft. from S. Line

990 Ft. from E. Line

----- Ft. from W. Line

			0

FIRST REPORTS

Location -----

Rig up -----

Drilling and Remarks:

R.O.G.

RECORD

Cased ----- in., ----- ft.

Sand -----

Gas -----

Oil -----

Total Depth -----

PRODUCTION

1st 24 hrs. Nat. -----

1st 24 hrs. after shot -----

Gas ----- Cu. Ft.

Dry Hole -----

Abandoned -----

Date

JUL 25 1928

S. J. LEWIS

Scout

Map No. KANSAS Sec. 8 Twp. 11 R. 15W

Well No. 1 Maier

Liggett & Co. Company

[Signature] Contractor

SECTION PLAT

990 Ft. from N. Line

_____ Ft. from S. Line

330 Ft. from E. Line

_____ Ft. from W. Line

			0

Correction

Location _____

Rig up _____

Drilling and Remarks:

Reported
SENEBE
should be
SENEBE

RECORD

Cased _____ in., _____ ft.

Sand _____

Gas _____

Oil _____

Total Depth _____

PRODUCTION

1st 24 hrs. Nat. _____

1st 24 hrs. after shot _____

Gas _____ Cu. Ft.

Dry Hole _____

Abandoned _____

Date

AUG 8 1928

S. J. LEWIS

Scout

MAP NO. KANSAS SEC. 8 TWP. 11 R. 15 W

WELL NO. 11111

Liggett & Co COMPANY

CONTRACTOR

SECTION PLAT

			0

990 FT. FROM N. LINE

FT. FROM S. LINE

330 FT. FROM E. LINE

FT. FROM W. LINE

ABANDONED

LOCATION _____

RIG UP _____

DRILLING AND REMARKS:

Goeham Sol
3308
NFW 3400
W 3433
W 3433

RECORD

CASED _____ IN. _____ FT.

SAND _____

GAS _____

OIL _____

TOTAL DEPTH 3433

PRODUCTION

1ST 24 HRS. NAT. _____

1ST 24 HRS. AFTER SHOT _____

GAS _____ CU. FT.

DRY HOLE _____

ABANDONED _____

DATE

NOV 14 1928

S. J. LEWIS

SCOUT