


Russell KANSAS

SECTION 8 TOWNSHIP 11 S RANGE 15 W

WELL NO. # 1 Maier

COMPANY R. P. Nixon

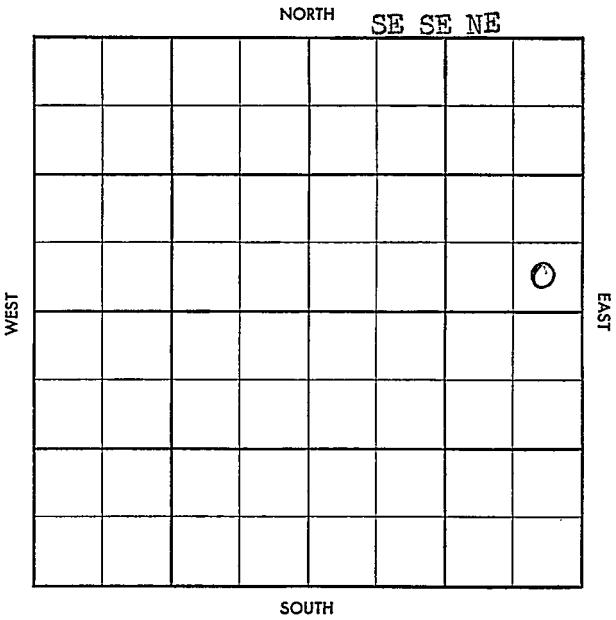

~~RESERVED~~ ~~RESERVED~~  
~~RESERVED~~ ~~RESERVED~~

S-513-B

County Russell Elev. \_\_\_\_\_  
 Sec. 8 Twp. 11 Rge. 15W  
 Company R. P. Nixon  
 Farm Name Maier No. 1

TOPS	DEPTH	LOG	DATUM
Anh.			
Tp.			
H.			
Tr.			
Dg.			
B.L.			
L.			
K.C.			
B.K.C.			
Ce.			
C.			
M.			
M.			
K.			
Mz.			
Mq.			
V.			
S.			
S.			
A.			
R.			
Pf.			
G.			
T.D.			

Loc. in Sec. \_\_\_\_\_  
SE SE NE  
 Geol. \_\_\_\_\_  
 Contr. \_\_\_\_\_  
Mast Drlg.  
 Pool \_\_\_\_\_  
Fairport

JUL 23 1938  
 FIRST REPORT

Date Comm. \_\_\_\_\_  
Location  
 \_\_\_\_\_  
 \_\_\_\_\_  
 \_\_\_\_\_  
 \_\_\_\_\_  
 \_\_\_\_\_  
 \_\_\_\_\_

Co. \_\_\_\_\_  
 Lse. \_\_\_\_\_  
 No. \_\_\_\_\_  
 Sec. \_\_\_\_\_  
 T. \_\_\_\_\_  
 R. \_\_\_\_\_

Top No. Pool ✓  
 Co. ✓ Face No. 40

5-512-B

County Russell Elev. 1914.06 19-186  
 Sec. 8 Twp. 11 Rge. 15<sup>W</sup>  
 Company H. P. Nixon  
 Farm Name Maier No. 1

TOPS	DEPTH	LOG	DATUM
Anh.	999		
H.			
Tp.	3000		
Tr.	3021		
Dg.			
B.L.			
L.	3046		
K.C.			
B.K.C.	3307		
Co.			
C.	3329		
M.			
M.			
K.			
Mz.			
Mq.			
V.			
S.			
S.			
A.			
R.			
Pf.			
G. <u>W</u>	3397		
T.D.	3402		

Loc. in Sec. SE SE NE  
 Geol. \_\_\_\_\_  
 Contr. \_\_\_\_\_  
 Pool Fairport  
East Brlg.

**ABANDONED**  
 AUG 13 58

Date Comm. 7-31-58 8" 1000/375  
 Locational 80 '58 AUG 6 '58 02450  
AUG 10 '58 20109

D6A

Co.  
 No.  
 Sec.  
 T.  
 R.