


DX 78-1

Section 8 Township 11 Range 19W

Well No. I Glinther

Company Okmar Oil

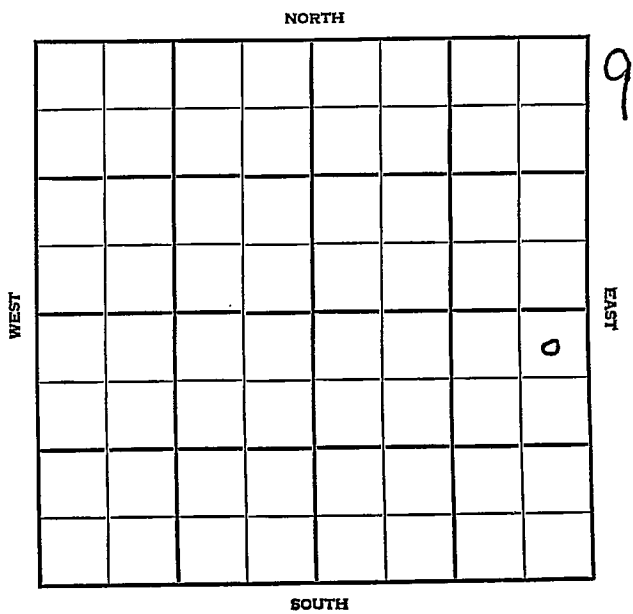

Ellis

KANSAS

SEC.	TWP.	R.
8	11	19W ✓

WELL NO. #1 Giinther FARM

COMPANY Okmar Oil


CONTRACTOR C & G Drlg.

330 Ft. from N. Line

Ft. from S. Line

330 Ft. from E. Line

Ft. from W. Line

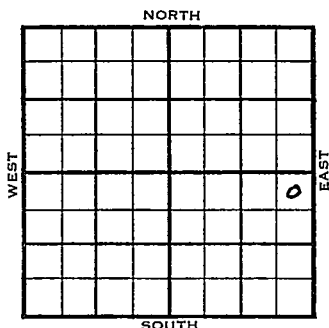

NE NE SE

	ELEVATION	REPORT
1954	2049'	

5/26 Spud 5-19-54  
8" @ 171'  
Anhy 1401'  
Drlg 2745'

6/2 Spud 5-19-54  
D&A  
TD 3653'  
8" @ 171'  
Anhy 1401', Top 3038', Heeb 3255',  
Tor 3277', Lans 3295', Cong. 3538',  
Simp. 3584', Arb. 3606'  
DST 3607-14, opn 1 hr., rec. 65' wcm,  
850#  
TD 3653'  
D&A

ABANDONED

County Ellis State Kansas

Sec. 8 (Blk.) 11 (Sur.) 19W Map No.

Operator Okmar Oil

Well No. 1 Farm Giinther

Elev. 2049 Location NE NE SE


330 Ft. From N Line SE

330 Ft. From E Line Quarter

1st. Report

Completion JUN 2 1954

Remarks

C & G Drlg. - Contr.

Spudding Date 5-19-54

Drlg. Data D & A TD 3653

8" @ 171 Anhy 1401 Top. 3038

Heeb. 3255 Tor. 3277 Lans. 3295

Cong. 3538 Simp. 3584 Arb. 3606

DST 3607-14 open 1 hr. Rec. 65' wcm

850# TD 3653

D & A

