

Ellis


KANSAS

SECTION 8 TOWNSHIP 11 RANGE 18W

WELL NO. #5 Cave

COMPANY N C R A

NORTH

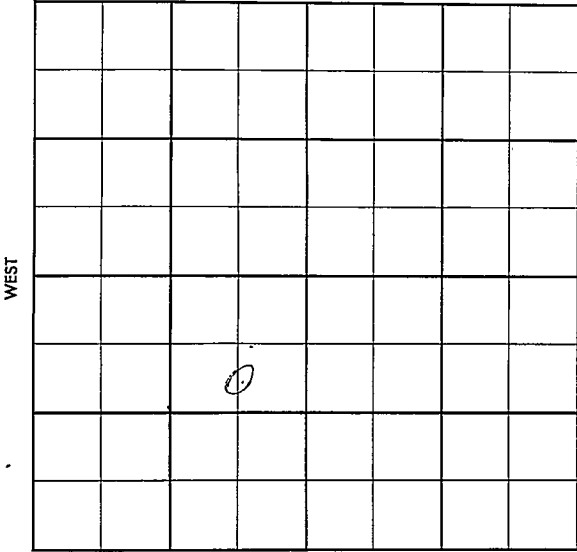

SOUTH

County ELLIS Elev. _____
 Sec. 8 Twp. 11 Rgs. 18W
 Company N C R A
 FarmName Cave No. 5

TOPS	DEPTH	LOG	DATUM
Anh.			
Tr.			
H.			
Tr.			
Dg.			
Bl.			
L.			
K.C.			
B.K.C.			
Ce.			
C.			
M.			
M.			
K.			
Mz.			
Mo.			
V.			
S.			
S.			
A.			
R.			
Pe.			
G.			
T.D.			

Loc. in Sec. C S $\frac{1}{2}$ NE SW
 Geol. _____
 Contr. Garvey
 Pool Cochran

FIRST REPORT	
6	
JAN 3 '57	

Date Comm. _____
 Location Location

Co. No. Lse. No. Sec. T. R.

County Elvis Elev. 1982
 Sec. 8 Twp. 11 Rgs. 18W
 Company N C R A
 Farm Name Cave No. 5

TOPS	DEPTH	LOG	DATUM
Anb.			
Ip.			
H.	3190		
Tr.	3209		
Dg.			
Bl.			
L.	3230		
K.C.			
B.K.C.			
Ce.			
C.			
M.			
M.			
K.			
Mz.			
Mo.			
V.			
S.			
S.			
A.	3563		
R.			
Pe.			
G.			
T.D.	3568		

Loc. in Sec. C S¹/₂ NE SW
 Geol. _____
 Contr. Garvey #14
 Pool 1/2 sec 8 T 11 R 18W
Cochran

COMPLETE
 MAR 20 '57

Date Comm. _____
 Location JAN 9 '57 1-7-57
JAN 15 '57 8578 224/150
DST 3231-45 in. 210 gaa +
120' oil + 26' Mdy oil BHP
745/20" DST 3245-75 JAN 23 '57
or 1hr. 550' GIR see 92' 50' 6CM
FP 55-75 BHP 175/20" DST
3275-3305 1hr 100' 50' 6CM
65-73 BHP 175/20 5 1/2 @ 3565/150

Co. No. Sec. T. R.

FEB 6 '57 CO 3568 $\$$ 5 1/2 GO no/w2 hrs 50 Gal Acid $\$$ 5 60no/w 1 hr 1/4 $\$$ 2. Bo + Tr4 hrs no/w 1/2 $\$$ 12 Bo + Trwt in 5 hrs DD 3570 $\$$ 21

Bo + Tr. wt 8 hrs Pop. FEB 13 '57

FEB 24 '57 FEB 20 '57 ✓ ED 7 '57 MAR 6 '57 MAR 13 '57

MAR 2 '57

Ph P. 44 Bo + ~~Tr~~

TRACE wt gran 17.5°

8-11-18W

CS/2 new