

KANSAS

Ellis

Section 8 Township 11 Range 20W

Well No. 1 Fischer

Company Francis Oil & Gas

Wildcat

NORTH

WEST

EAST

				0			

SOUTH

2

KANSAS Ellis

Sec. 8 Twp. 11 R. 20W ✓

Well No. #1 Fischer Farm

Francis Oil & Gas Company

Wildcat (Veeder Supply, Cont.) NORTH


330' Ft. from N. Line

Ft. from S. Line

Ft. from E. Line

330' Ft. from W. Line

NW NE

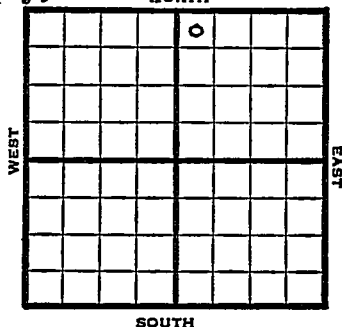

1949

Elev 2060' REPORT

6/15 Location

6/21 8" @ 275'
rlg 1559'

6/29 TD 3713'

Lans 3348'

Arb. 3656'

Aband.

ABANDONED

Ellis County Kansas State

Map No. _____ Sec. 8 Twp. 11 R. 20W

Well No. 1 Fischer

Francis Oil & Gas Company

Veeder Supply Contractor

NW NE


FIRST REPORT SECTION PLAT

330 Ft. from N. Line

_____ Ft. from S. Line

_____ Ft. from E. Line

330 Ft. from W. Line

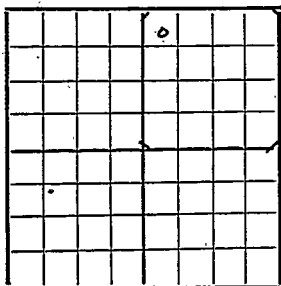

Wildcat

Remarks:

Location

Date JUN 15 1949

Scout S. J. LEWIS

Map No. K 70 Sec. 8 Twp. 11 R. 20WWell No. 1 Fischer

Francis Oil & Gas Company

ABANDONED


Contractor

NW NE

E 12060
SECTION PLAT330 Ft. from N. Line

Ft. from S. Line

Ft. from E. Line

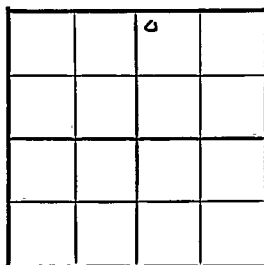330 Ft. from W. Line

Ellis County

Location

Rig up

Drilling and Remarks:

Lease 9848Cr 73656

RECORD

Cased _____ in., _____ ft.

Sand _____

Gas _____

Oil _____

Total Depth 3713

PRODUCTION

1st 24 hrs. Nat. _____

1st 24 hrs. after shot _____

Gas _____ Cu. Ft.

Dry Hole _____

Abandoned _____

Date

JUN 29 1949

19

S. J. LEWIS

Scout