

Sec. 8 Twp. 11 R. 17-W

Well No. ~~#2~~ Carmichael "D" #3 Farm

Dickey Company


(Bemis)

_____ Ft. from N. Line

660 Ft. from S. Line

990 Ft. from E. Line

_____ Ft. from W. Line

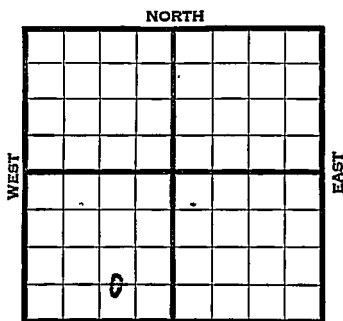

Elev. 1830

1941	REPORT
9/10	Location
9/18	Derrick.
9/25	Drlg. 811'
10/2	Drlg. 2160'
10/9	Drlg. 3152'
10/16	SD 3488'
10/23	Arb. 3475' T.D. To P.B. & set whipstock.
10/30	Shut down.
11/6	" "
11/13	Whipstock at 1400' Drlg. 1630'
11/20	Drlg. 2360'
11/26	2500' crooked hole. P.B. to 2200'
12/4	Drlg. 3000'
12/11	Art. 3370 71 Tq 7" @ 3371 RUST
12/18	TD 3376 500 acid
12/24	3000 acid. Potential 69 bbls., pump.

OVER

1941

12/30

Arb. 3370

7" @ 3371

TD 3376 3500 acid.

Pump ~~56~~ Potential 67

34.6 Grav.

COMPLETED

Map No. _____ Sec. 8 Twp. 11 R. 17WWell No. 2 Carmichael "D"_____ Dickey _____ Company

_____ Contractor

FIRST REPORT

C WL SE SW

_____ Ft. from N. Line

660 Ft. from S. Line990 Ft. from E. Line

_____ Ft. from W. Line

SECTION PLAT

	0		

BEMIS POOL

Location X

Rig up _____

Drilling and Remarks:

RECORD

Cased _____ in., _____ ft.

Sand _____

Gas _____

Oil _____

Total Depth _____

PRODUCTION

1st 24 hrs. Nat. _____

1st 24 hrs. after shot _____


Gas _____ Cu. Ft.

Dry Hole _____

Abandoned _____

Date

SEP 10 1941 19 _____ S. I. LEWIS Scout

 

Faint, illegible text or markings on the right side of the page.

- Misc Small Maps
- Cards
- Tracing
- France Map
- Scarborough Map
- Moody Map
- Geological Dept.
- Moody-Plat Book

[Handwritten signatures and initials, including 'J.M.' and 'J.P.', are written over the list items.]

Map No. K-71 Sec. 8 Twp. 11 R. 17W

Well No. 3 Carmichael "D"

Dickey Company

CORRECTION Contractor

C WL SE SW

_____ Ft. from N. Line

660 Ft. from S. Line

990 Ft. from E. Line

_____ Ft. from W. Line

SECTION PLAT

	0		

BEMIS POOL

Location _____

Rig up _____

Drilling and Remarks:

Changed from
#2 to #3

RECORD

Cased _____ in., _____ ft.

Sand _____

Gas _____

Oil _____

Total Depth _____

PRODUCTION

1st 24 hrs. Nat. _____

1st 24 hrs. after shot _____

Gas _____ Cu. Ft.

Dry Hole _____

Abandoned _____

Date

SEP 24 1941

19

S. J. LEWIS Scout

Misc. Small Maps

Cards

Tracing

France Map

Scarborough Map

Moody Map

Geological Dept.

Moody Plat Book

DAW
DAW
DAW
DAW
DAW

Ellis

KANSAS

Map No. 71 Sec. 8 Twp. 11 R. 17W

Well No. 3 Carmichael "D"

Dickey Company

COMPLETED Contractor

C WL SE SW

SECTION PLAT

_____ Ft. from N. Line

660 Ft. from S. Line

990 Ft. from E. Line

_____ Ft. from W. Line

BEMIS POOL

RECORD

Location _____

Cased _____ in., _____ ft.

Rig up _____

Sand _____

Drilling and Remarks:

Gas _____

Oil _____

Total Depth 3376

Cor 83370

7" @ 3371

PRODUCTION

1st 24 hrs. Nat. _____

1st 24 hrs. after shot _____

Gas _____ Cu. Ft.

Dry Hole _____

Abandoned _____

3500 acid
Pump 69 P.D.

34 1/2 Gr

Date

DEC 30 1941

S I LEWIS Scout

Misc. Small Maps	RAM
Cards	RAM
Tracing	RAM
France Map	RAM
Scarborough Map	RAM
Moody Map	RAM
Geological Dept.	
Moody Flat Book	