


Section 8 Township 11 Range 17W

Well No. #4 Gumble

Company Lee Phillips Oil

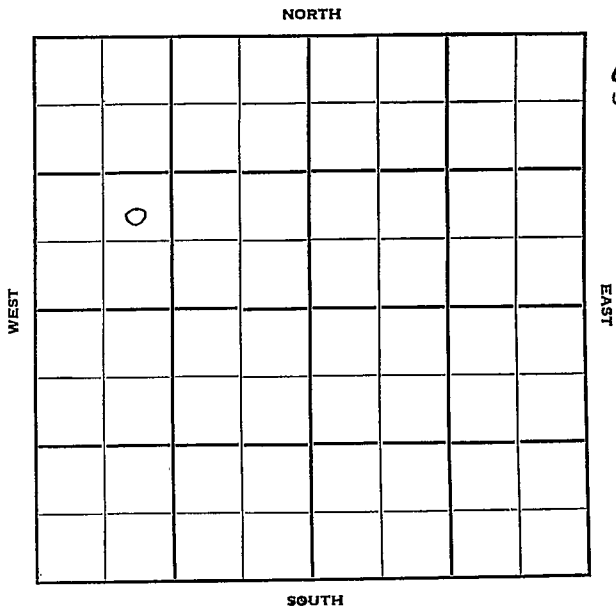

Ellis

KANSAS

Sec. 8 Twp. 11 R. 17W

Well No. #4 Gumble Farm

Lee Phillips Oil Company

Peel Drlg. Contractor

Burnett Pool


 Ft. from N. Line

990' Ft. from S. Line

 Ft. from E. Line

990' Ft. from W. Line

NE SW NW

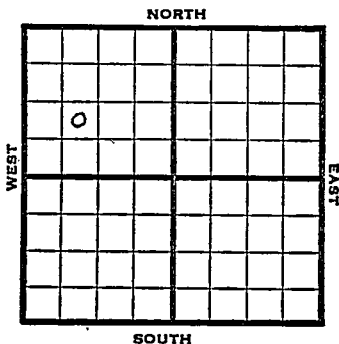

1951

Elev. 1863' REPORT

9/5
11/7

RUR

Spud 8-31-51

Oil well TD 3425

8" @ 816

Top. 2900

Lans. 3097

Cong. 3360

Simp. 3385

Arb. 3413

TD 3425

5" @ 3413' S/ 8 GOPH 500 A

S/ 4 BOPH

Comp. 40 BOPD 6% wtr.

COMPLETED

County Ellis State Kansas

Sec. 8 (Blk.) 11 (Sur.) 17E Map No.

Operator Lee Phillips Oil

Well No. 4 Farm Gumble

Elev. _____ Location NE SW NW

990 Ft. From S Line NW

990 Ft. From W Line Quarter

Ist. Report SEP 5 1951

Completion _____

Remarks _____

Spudding Date _____

Drlg. Data Burnett Pool

R U R

County Ellis State Kansas
 Sec. 8 (Blk. 11) (Sur. 17W) (Twp.) (Rge.) Map No.
 Operator Lee Phillips Oil
 Well No. 4 Farm Gumble
 Elev. 1863 Location NE SW NW

990 Ft. From S Line NW
990 Ft. From W Line Quarter

Ist. Report

Completion NOV 7 1951

Remarks Burnett Pool

Peel Drlg. - Contr.

Spudding Date 8-31-51

Drlg. Data Oil well TD 3425

8" @ 816 Top. 2900 Lans. 3097

Cong. 3360 Simp. 3385 Arb. 3413

TD 3425 5" @ 3413 S/ 8 goph 500 A

S/ 4 boph Comp. 40 bopd 6% water

J. E. TYRA