


Section 8 Township 11 Range 17W

Well No. #5 Gumble

Company Lee Phillips

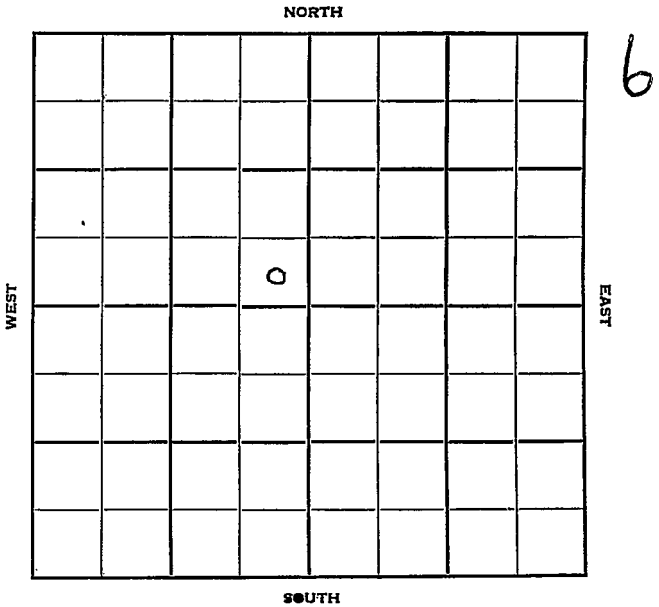

Ellis

Sec. 8 Twp. 11 R. 17W ✓

Well No. #5 Gumble Farm

Lee Phillips Company

Contractor

Burnett


Ft. from N. Line

330 Ft. from S. Line

330 Ft. from E. Line

Ft. from W. Line

SE SE NW

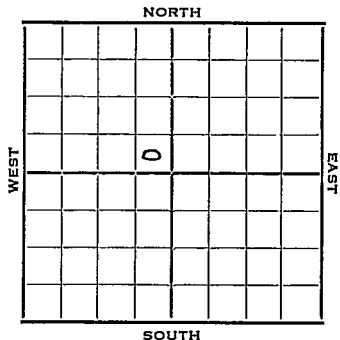

1952

Elev. 1859' REPORT

1/16

Spud 1-12-52
8" @850'
WOC

2/6

Lans. 3086
DST 3277-85, 10 mins. 5' OCM
400# BHP Arb. 3412-16
5" @ 3414, DD 3418 300 A
S/ 25 BOPD POP

2/13

No report

2/20

Spud 1-12-52
Oil Well TD 3418
8" @ 850
Lans. 3086
DST 3277-85 opn 10 min.
Rec. 5' ocm Arb. 3412-16
5" @ 3414 TD 3418 300 A
S/25 Bopd Comp.201 bopd

COMPLETED

County Ellis State Kansas

Sec. 8 (Blk. Twp.) 11 (Sur. Rge.) 17W Map No.

Operator Lee Phillips

Well No. 5 Farm Gumble

Elev. 1859 Location SE SE NW

330 Ft. From S Line NW

330 Ft. From E Line Quarter

Ist. Report JAN 16 1952

Completion _____

Remarks _____

Spudding Date 1-12-52

Drlg. Data Burnett

8" @ 850 W.O.C.

J. E. TYRA

