


Section 8 Township 11 Range 17W

Well No. #2 Gilbert

Company Lario Oil

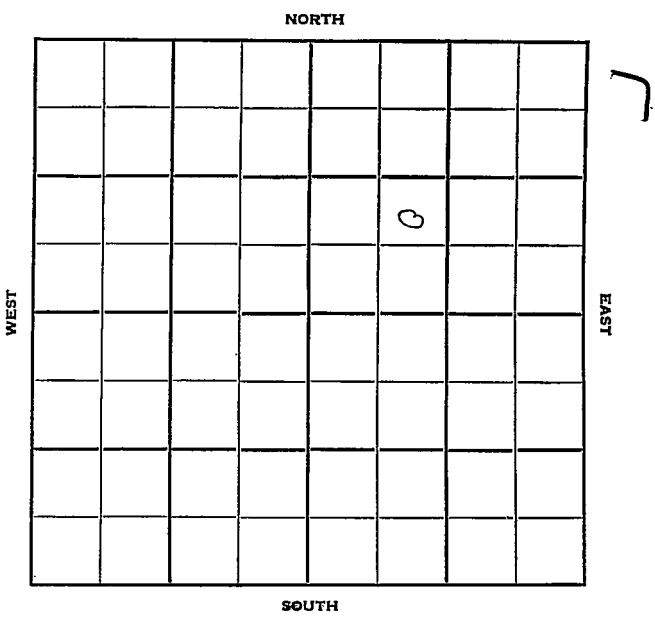

Ellis

KANSAS

Sec. 8 Twp. 11 R. 17 W

Well No. # 2 Gilbert Farm

Lario Oil Company

Contractor


Ft. from N. Line

990 Ft. from S. Line

Ft. from E. Line

990 Ft. from W. Line

NE SW NE

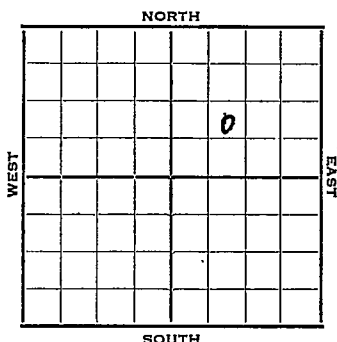

1952 Elev. 1862' DF REPORT

6/18 Spud 6-8-52
8" @ 1119' Anhy 1109' Topeka 2814'
Heeb 3046' Tor. 3064' Lans. 3086'
DST 3181-92, 1 hr, 10' M 950#
DST 3242-65 3/4 hr. 4' M 0#
BKC 3321' Fishing 3357'
6/25 Cong. 3347' Simp. 3409' Arb. 3432'
RTD 3435' 5" @ 3432' CO 3435'
B/4 BOPH POP

7/2 NR

7/9 Spud 6-8-52
Oil well TD 3435' 8" @ 1119
Anhy 1109' Top. 2814' Heeb 3046'
Tor. 3064' Lans. 3086'
DST 3181-92 open 1 hr, rec 10' mud
DST 3242-65 open 3/4 hr. rec 4' mud
B K 3321' Cong. 3347'
DST 3335-54 open 3/4 hr. rec 3' mud
Simp. 3409' Arb. 3432'
DST 3410-35 open 1/2 hr. rec 400' oil,
140' HOCM, 5" @ 3432 CO to 3435
B/4 BOPH
Comp. 119 BOPD 40% water.

COMPLETED


J. G. McGEHEE

County Ellis State Kansas
 Sec. 8 (Blk. 11 (Sur. 17W Map No. 11 (Rge. 17W)

Operator Lario Oil

Well No. 2 Farm Gilbert

Elev. 1862 Location NE SW NE

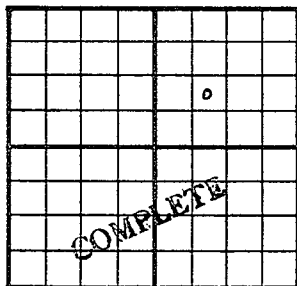

990 Ft. From S Line NE

990 Ft. From W Line Quarter

1st. Report

Completion JUL 9 1952

Remarks

Spudding Date 6-8-52

Drilg. Data Oil well TD 3435

8" @ 1119 Anhy 1109 Top. 2814

Heeb. 3046 Tor. 3064 Lans. 3086

DST 3181-92 open 1 hr. Rec. 10' mud

DST 3242-65 open 3/4 hr. Rec. 4' mud

B KC 3321 Cong. 3347 DST 3335-54

open 3/4 hr. Rec. 3' mud Simp. 3409

Arb. 3432 DST 3410-35 open 1/2 hr.

Rec. 400' oil 140' hbcn 5" @ 3432

CO to 3435 B/ 4 boph

Comp. 119 bopd 40% water