


Section 9 Township 11 Range 15W

Well No. #1 ~~Shober~~ Ramsey

Company ~~Ramsey et al~~ MURFIN OIL Co

NORTH

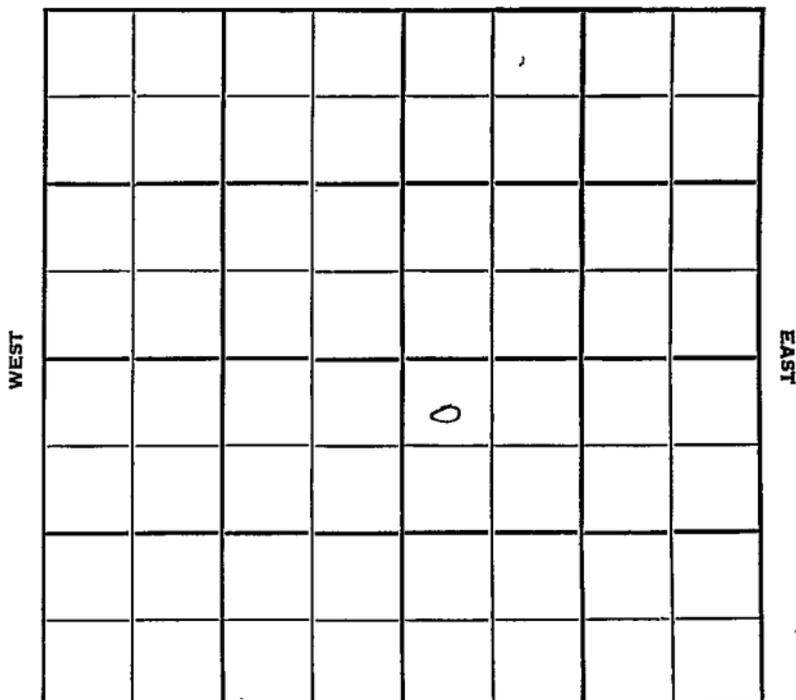

SOUTH

Sec. 9 Twp. 11 R. 15W

Well No. #1 Ramsey
~~#1 Sheber~~

Farm _____
Company Ramsey et al

Contractor Murfin - Contr.
Fairport


330' Ft. from N. Line

_____ Ft. from S. Line

_____ Ft. from E. Line

330' Ft. from W. Line

NW NW SE

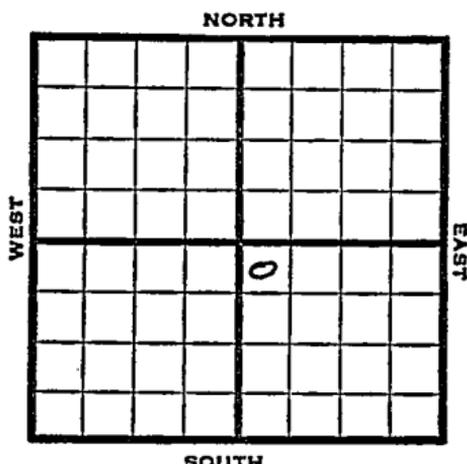

1952

Elev. 1943' REPORT

2/6

Location

2/13

"

2/20

8" @ 179' WOC

3/5

Gorham 3405'
Arb. 3407-11' RTD
5" @ 3408' WOC

3/12

WOCT

3/19

"

3/25

"

4/1

RUST

4/9

DP 500 A S/ 5 to 7 boph
POP

4/16

Spud 2-17-52
Oil well TD 3411' 8" @ 179
Anhy 1018' Top. 2769' Heeb 3019'
Dodge 3040' Lans. 3070' Gorham 3405'
Arb. 3407-11' TD 5" @ 3408'
500 A S/5 to 7 BOPH
Comp. 30 BOPD
COMPLETED

Map No. _____ Sec. 9 Twp. 11 R. 15WWell No. 1 Ramsey

Murfin Drlg.

Company

CORRECTION

Contractor

NW NW SE

SECTION PLAT330 Ft. from N. Line

_____ Ft. from S. Line

_____ Ft. from E. Line

330 Ft. from W. Line

		o.	

Location _____

Rig up _____

Drilling and Remarks:

Reported

Ramsey et al

1 Shot

RECORD

Cased _____ in., _____ ft.

Sand _____

Gas _____

Oil _____

Total Depth _____

PRODUCTION

1st 24 hrs. Nat. _____

1st 24 hrs. after shot _____

Gas _____ Cu. Ft.

Dry Hole _____

Abandoned _____

Date

APR 9 1952

J. G. McGEHEE

19

Scout

